


May M. Masley
Vol. 568, P. 33
Deed Records

BASIS OF BEARINGS: SEE SURVEY OF WEST EVANS CREEK ROAD BY DEPT. OF PUBLIC WORKS
RIGHT OF WAY MONUMENTS ARE 5/8" IRON PINS

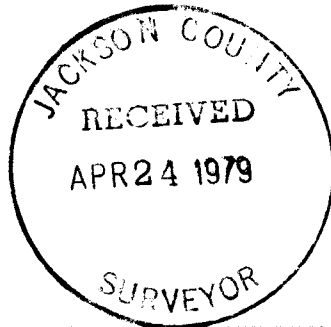

SURVEY FOR: DENNY BELL	
LOCATION: SW 1/4 SEC. 33, T.34 S., R. 4 W.W.M. JACKSON COUNTY, OREGON	
DATE: APRIL 18, 1979	REGISTERED PROFESSIONAL LAND SURVEYOR
SCALE: 1"=200'	
● MONUMENTS FOUND	Paul W. Edwards OREGON JULY 8, 1968 DARREL W. EDWARDS 741
○ 5/8" STEEL PINS SET	
××××× FENCE LINES	
() RECORD MEASUREMENT	

SURVEY NO. 7782

SURVEY NARRATIVE TO COMPLY WITH PARAGRAPH 209.250 O.R.S.

SURVEY FOR: Denny Bell
10401 W. Evans Cr. Rd.
Rogue River, Oregon

LOCATION: SW 1/4 Section 33, Township 34 South, Range
4 West of the W.M. in Jackson County, Oregon.


PURPOSE: To locate and monument property boundaries
as shown on the accompanying plat.

PROCEDURE: Found necessary monuments and subdivided
section and SW 1/4 Section 33 as shown on
attached map; Surveyed and monumented 3
parcels in the S. 1/2 of the SW 1/4 said
section as per deed records.

BASIS OF BEARINGS: See survey of West Evans Cr. Rd.
by the Dept. of Public Works.

DATE COMPLETED: April 18, 1979

Darrel W. Edwards
5721 Rogue River Hwy.
Gold Hill, Or. 97525

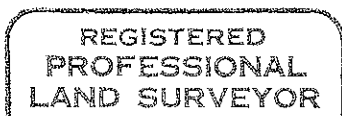

Darrel W. Edwards

