


BASIS OF BEARINGS: RS. NO. 7683

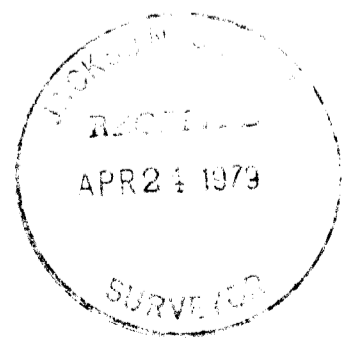

SURVEY FOR: WINSTON C. FULLER	
LOCATION: NW 1/4 Sec. 5, T. 36 S., R. 4 W.W.M. JACKSON COUNTY, OREGON	
DATE: 4-4-79	REGISTERED PROFESSIONAL LAND SURVEYOR <i>Darrel W. Edwards</i> OREGON JULY 9, 1964 DARREL W. EDWARDS 741
SCALE: 1"=100'	
● MONUMENTS FOUND	
○ 5/8" STEEL PINS SET	
() RECORD MEASUREMENTS	
-x-x- FENCE LINES	

30475

SURVEY NO. 7783

SURVEY NARRATIVE TO COMPLY WITH PARAGRAPH 209.250 O.R.S.

SURVEY FOR: Winston C. Fuller

LOCATION: NW 1/4 Section 5, Township 26 South, Range 4
W.W.M. in Jackson County, Oregon.


PURPOSE: To determine and monument property bound-
aries as shown on accompanying plat.

PROCEDURE: Found Brass Cap at North 1/16 Cor. and 5/8"
iron rod on Section Line as per R.S. 6080;
Surveyed and monumented parcel as shown on
attached map, *as per deed records.*
DWE

BASIS OF BEARINGS: R.S. 6080

DATE COMPLETED: April 4, 1979

Darrel W. Edwards
5721 Rogue River Hwy.
Gold Hill, Or. 97525

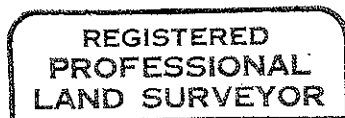

Darrel W. Edwards

