


BASIS OF BEARINGS: RS NO. 6860

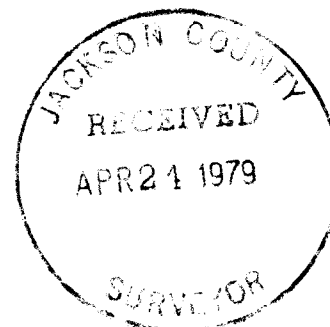

SURVEY FOR: BEVERLY LEVY	
LOCATION: SE 1/4 Sec. 17, T. 35 S., R. 4 W.W.M. Jackson County, Oregon	
SCALE: 1" = 100'	REGISTERED PROFESSIONAL LAND SURVEYOR
DATE: March 25, 1979	
● Monuments Found	<i>Darrel W. Edwards</i> OREGON JULY 2, 1966 DARREL W. EDWARDS 67
○ 5/8" Steel Pins Set	
() Record Measurements	

SURVEY NO. 7784

SURVEY NARRATIVE TO COMPLY WITH PARAGRAPH 209.250, O.R.S.

SURVEY FOR: Beverly Levi
General Delivery
Rogue River, Oregon

LOCATION: SE 1/4 Section 17, Township 35 South,
Range 4 W.W.M. in Jackson County, Oregon.

PURPOSE: To locate and monument property boundaries
as shown on accompanying plat.

PROCEDURE: Found necessary monuments on East/West
centerline Section 17; Surveyed and mon-
umented 5 acre parcel as per deed records.

BASIS OF BEARINGS: R.S. 6860

DATE COMPLETED: March 25, 1979.

Darrel W. Edwards
5721 Rogue River Hwy.
Gold Hill, Or. 97525

REGISTERED
PROFESSIONAL
LAND SURVEYOR

Darrel W. Edwards

OREGON
JULY 8, 1956
DARREL W. EDWARDS
741

