


17 16
20 21
BRASS CAP
SEC. COR.

N

BASIS OF BEARINGS: SURVEY NO. 3304

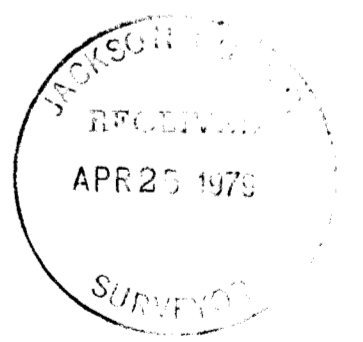

SURVEY FOR: ADAMS & BUNN	
LOCATION: NE 1/4 SEC. 20, T.37 S., R.1 W.W.M. JACKSON COUNTY, OREGON	
DATE: APRIL 5, 1979	REGISTERED PROFESSIONAL LAND SURVEYOR
SCALE: 1"=100'	
-x-x- FENCE LINES	 OREGON JULY 8 1958 DARREL W. EDWARDS 741
• MONUMENTS FOUND	
○ 5/8" STEEL PIN SET UNLESS OTHERWISE NOTED	

SURVEY NO. 7789

SURVEY NARRATIVE TO COMPLY WITH PARAGRAPH 209.250 O.R.S.

SURVEY FOR: Gregg Adams
2120 Oakwood Dr.
Medford, Oregon

LOCATION: NE 1/4 Section 20, Township 37 South, Range
1 West of W.M. in Jackson County, Oregon.

PURPOSE: To locate and monument property boundaries
as shown on accompanying plat and prepare
descriptions of same.

PROCEDURE: Found Brass Cap at NE Cor., N. 1/4 Cor., CN
1/16 Cor. and EN 1/16 Cor. of Sec. 20; Sur-
veyed and monumented 3 parcels as shown on
attached plat.

BASIS OF BEARINGS: R.S. 3304

DATE COMPLETED: April 5, 1979

Darrel W. Edwards
5721 Rogue River Hwy.
Gold Hill, Or. 97525

