

7793


PROPERTY SURVEY
SITUATE IN
NW 1/4 SEC 3 T 39 S R 3 W WM
JACKSON COUNTY OREGON
G W PLUMB LAND SURVEYOR
MED FORD OREGON 18 APRIL 1979

REGISTERED
PROFESSIONAL
LAND SURVEYOR

G. W. Plumb

OREGON
JULY 12, 1966
G. W. PLUMB
862

JACKSON COUNTY
RECEIVED
APR 26 1979
SURVEYOR

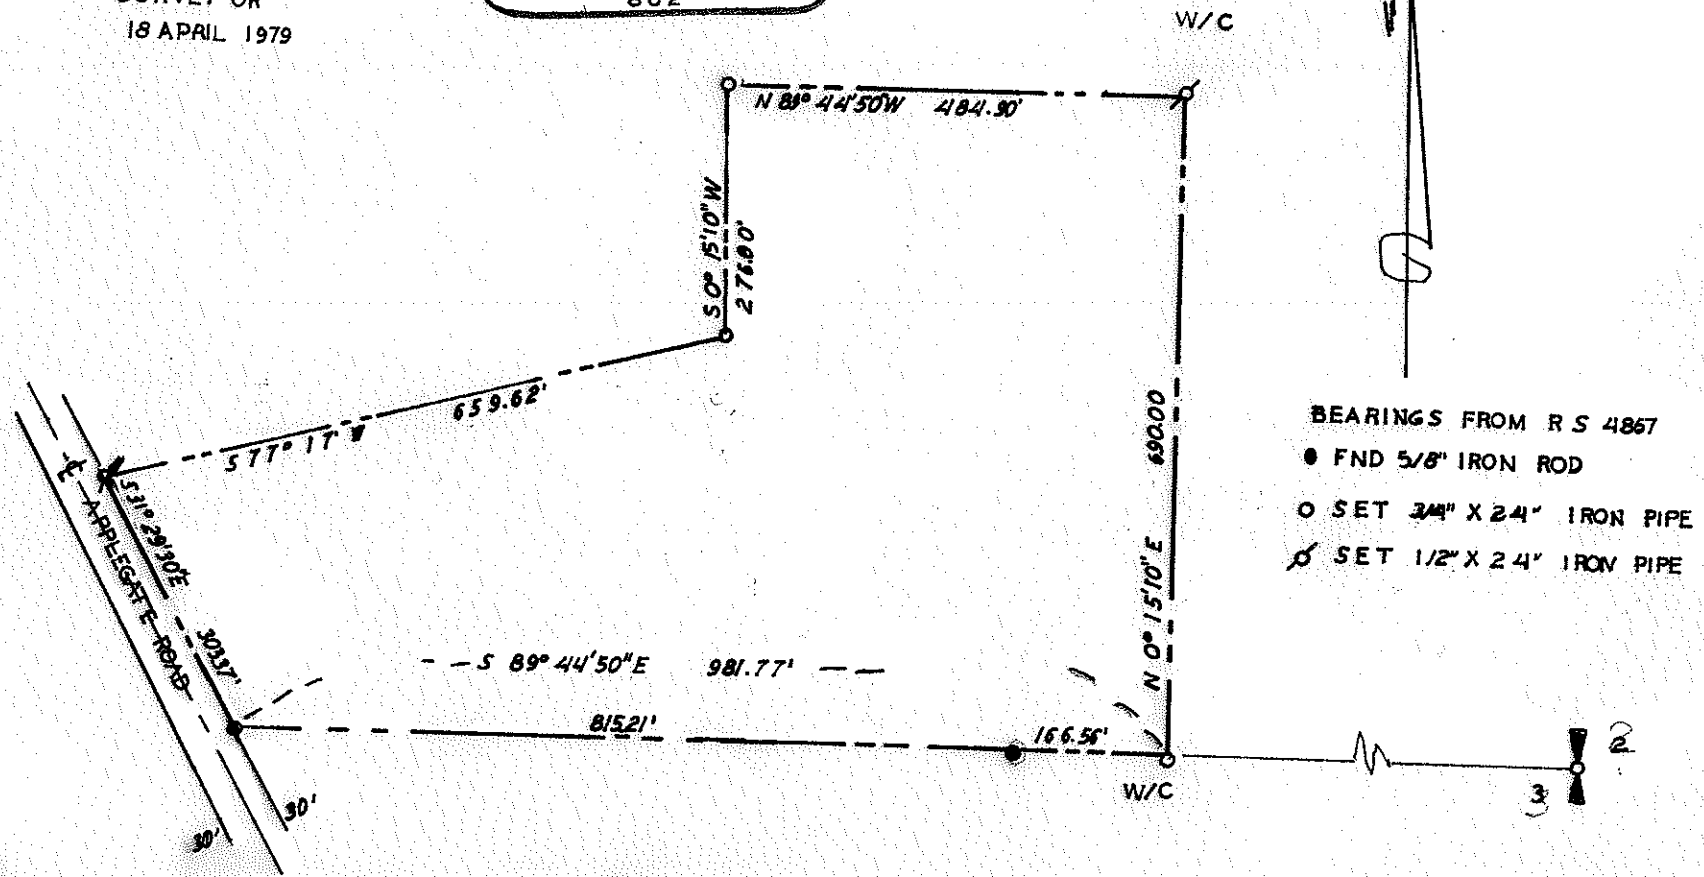


7793

Survey for Randall D. Jones
 C/O Progressive West Real Estate
 P.O. Box 4706
 Medford, Oregon 97501

Survey by G.W. Plumb, Land Surveyor
 P.O.Box 904
 Medford, Oregon 97501

Location Northwest 1/4, S. 3, T. 39 S. R.3 W., W.M.
 Jackson County, Oregon

Found 5/8 inch iron rod on Easterly side of Applegate Road per R.S. #7377 And 5/8 inch iron rod 815.21 feet Easterly from Applegate Road. Set iron pipe witness corners on theoretical North South 16th Section line. Set iron pipes as requested by client and as shown on the accompanying map.

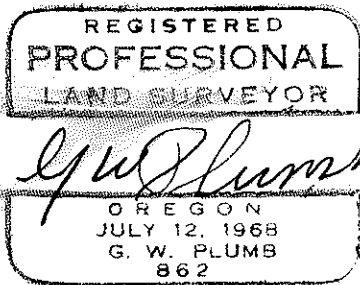

April 18, 1979

