
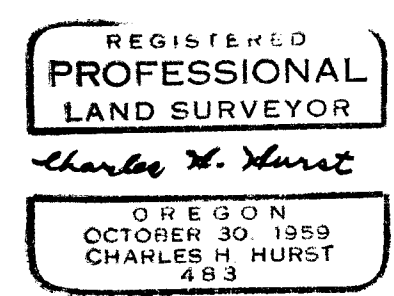


SAWYER ROAD LOCATION
 SURVEY IN SECTIONS 8, 9 & 16, T. 34 S., R. 1 W., W.M.,
 JACKSON COUNTY, ORE.

FOR
 LA VERNE EDWARDS, ET AL.

SURVEY BY
 CHARLES H. HURST
 MEDFORD, OREGON

LEGEND
 • SET 5/8" X 24" IRON PIN P.I.'S

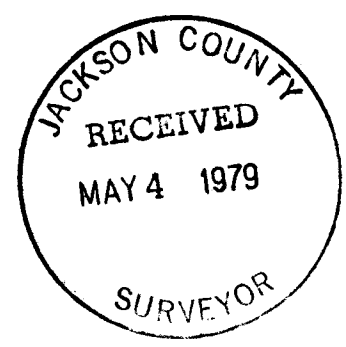

JAN 26 1979

FD. CTR. 1/4 COR.
 3/4" IRON PIN
 (SURVEY NO. 3495)

FD. C. 1/16 COR.
 3/4" IRON PIN
 (SURVEY NO. 3633)

FD. 1/4 COR.
 1" IRON PIPE

SURVEY NARRATIVE TO COMPLY WITH PARAGRAPH 209.250
OREGON REVISED STATUTES

7804

Survey for: La Verne Edwards, et. al.
1111 Netherland Road
Trail, Oregon 97541

Survey by : Charles H. Hurst
404 South Holly
Medford, Oregon 97501

Bearings : Based on Survey No. 3495 (N-S centerline of Section 16)

Purpose : To locate the centerline of Sawyer Road as it now exists.

PROCEDURE

The entire road was measured with electronic distance measuring equipment.

Points of tangent intersections were monumented with 5/8" iron pins.

Sawyer Road is variable in width and conforms to the centerline as shown subject to minor deviations within 30 feet of each side thereof.

January 26, 1979

