

SURVEY FOR:



**C. NORMAN GAIL**

LOCATED IN THE NW 1/4,  
 SEC. 22, T. 36 S. R. 3 W., W.M.  
 GOLD HILL, OREGON  
 BY: BOYDEN SURVEYING  
 SURVEY COMMENCED JAN. 1976  
 SURVEY COMPLETED MAY 10, 1979

SCALE 1" = 100'

BASIS OF BEARINGS  
 RECORDED SURVEY NO. 3891

- FOUND 3/4" IRON PIN FLUSH
- SET 3/4" x 30" IRON PIN FLUSH

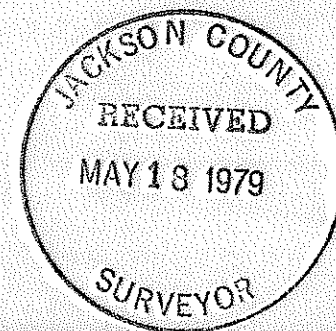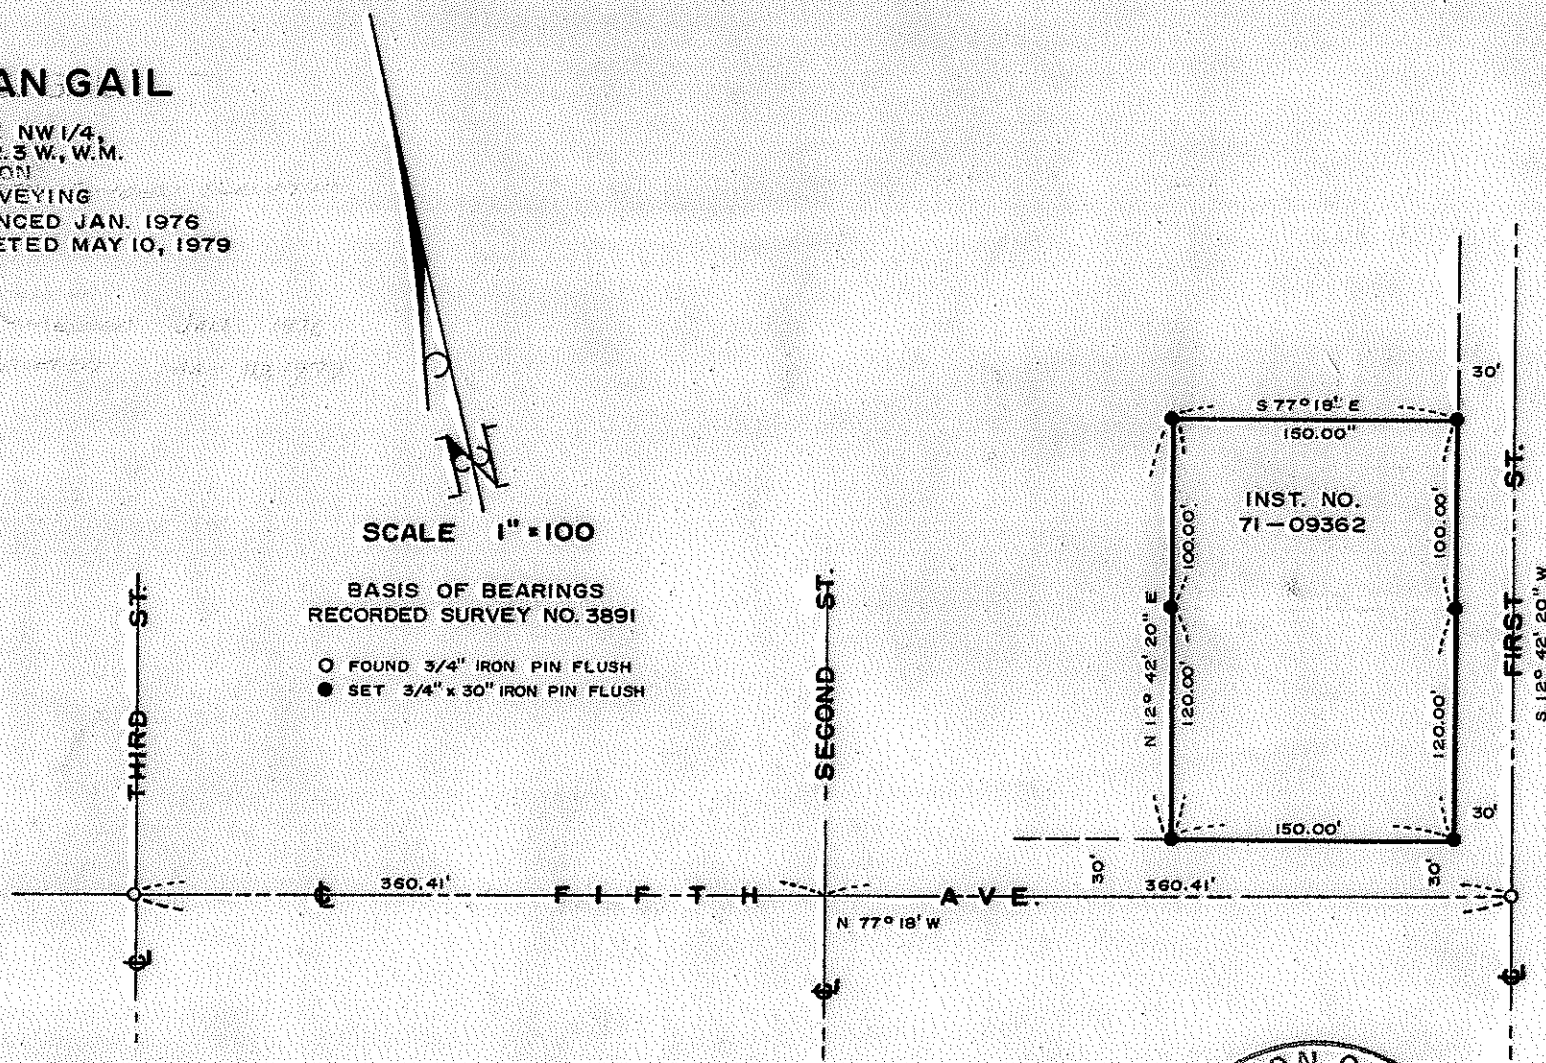

REGISTERED  
 PROFESSIONAL  
 LAND SURVEYOR

*Gary D. Kaiser*

OREGON  
 JULY 16, 1987  
 GARY D. KAISER  
 No. 803

Survey No. 7832

SURVEY NARRATIVE TO COMPLY WITH O.R.S. 209.250

FOR: C. Norman Gail  
135 Fifth Avenue  
Gold Hill, Oregon

PURPOSE: To monument the tract described in Instrument No.  
71-09362 O.R. located in Section 22, T36SR3W.

PROCEDURE: From monuments set on the center line of Fifth Avenue  
in the City of Gold Hill, Oregon on Recorded Survey  
No. 3891, the desired tract was monumented as shown  
on the annexed plat.

May 10, 1979

