

7838

Date: May 22, 1979
Survey For: Medford Resources Corporation
P. O. Box 550
Medford, Oregon 97501
Survey By: Arthur R. Rambo


Basis of Bearing: Section 30 bearing tree

Purpose: To mark new bearing tree for one cut down in logging operation.


Found 2½" B.L.M. Brass Cap Stamped:

T35S
R2E ¼ R3E
S25 S30
1963

with the Southeast B.T., 11½" white fir, unopened. Also found 12" white Fir stump with a B.T. tag nailed to the top. Chopped into the stump and found scribe. Scribed new B.T., 7" White Fir, 1/4 S25 in upper face, and B.T. in lower face which bears N67½° W 30.3 ft.

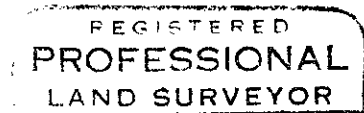

Arthur R. Rambo

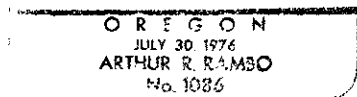

T35S, R2E, S25 - T35S, R3E, S30 ¼ COR.