


S 28 T 35 S R 3 E W.M.  
 JACKSON COUNTY, OREGON  
 JUNE 15, 1979  
 SCALE 1" = 300'

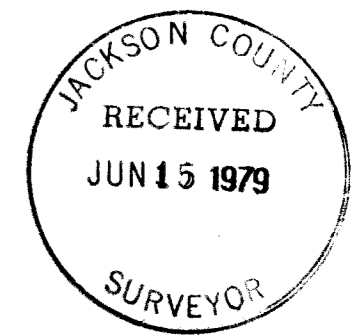

- FOUND B.L.M. BRASS CAP
- FOUND UNOFFICAL B.L.M. BRASS CAP
- FOUND C. S. BRASS CAP
- SET 1 1/2" ALUM. CAP ON 5/8" X 30" REBAR
- SET 5/8" X 30" REBAR
- WITNESS PINS 5/8" X 30" REBAR

REGISTERED  
 PROFESSIONAL  
 LAND SURVEYOR  
*Arthur R. Rambo*  
 OREGON  
 JULY 30, 1976  
 ARTHUR R. RAMBO  
 No. 1056



T35S R3E

$\frac{1}{4}$   
S28|S27

1977

From which

An 8 inch Fir bears S79° 05' E 41.9 feet dist. marked  $\frac{1}{4}$ S27BT

An 11 $\frac{1}{2}$  inch Fir bears N89° 24' W 10.8 feet dist. marked  $\frac{1}{4}$ S28 LS1086BT

Section corner common to Sections 27,28,34, and 33 T35S R3E W.M.

At the corner location I found a standard BLM monument marked:

T35S R3E

S28|S27  
S33|S34

1962

From which

A 15 inch Fir bears S76° 16' E 21.4 feet dist. unopened

A 22 inch Fir bears N5° 31' E 10.6 feet dist. unopened

An 18 inch Fir bears N45° 19' W 8.5 feet dist. unopened

A 20 inch Fir bears S13° 29' W 44.4 feet dist. unopened

A 25 inch Fir bears S47° 41' E 31.4 feet dist. unopened (CS tree)

A 24 $\frac{1}{2}$  inch Fir bears N45° 19' W 34.5 feet dist. unopened (CS tree)

One-quarter corner common to Sections 28 and 33 T35S R3E W.M.

At the corner location I found a standard BLM monument marked:

T35S R3E

$\frac{1}{4}$  — S28 —  
S33

1966

From Which

A 15 inch Fir bears N49° 58' E 37.4 feet dist unopened

A 39 $\frac{1}{2}$  inch Fir bears N46° 04' W 5.6 feet dist. unopened

A 23 inch Fir bears S69° 05' W 7.8 feet dist. marked with 4 in  
chopped out upper face

A 14 inch dead Fir bears S28° 13' W 31.1 feet dist. marked  $\frac{1}{4}$ S33BT

At the Center West one-sixteenth corner of Section 28 T35S R3E

W.M. I set a 5/8" by 30" rebar with 1 $\frac{1}{2}$ " Alum. cap marked:

LS1086

S28


CW1/16 +

T35S R3E

From which

A 7inch Fir bears N2° 28' W 38.5 feet dist. marked CW1/16 LS1086BT

A 6 inch Fir bears S 14° 08' W 23.6 feet dist. marked CW1/16 LS1086BT

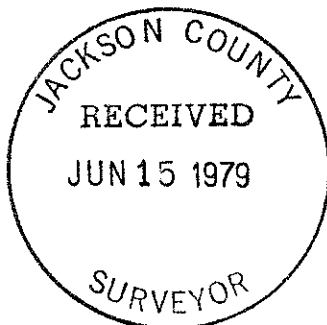

*Arthur R. Rambo*



T35S R3E  
N 1/16  
S29 | S28  
1978

From which

A 6 inch Fir bears S22° 12' E 29.1 feet dist. marked N1/16 S28 BT  
A 9 inch Fir bears S57° 10' W 40.4 feet dist. marked N1/16 S29 BT

Section corner common to Sections 20,21,28, and 29 T35S R3E W.M.  
At the corner location I found a standard BLM monument marked:

T35S R3E  
20|21  
29|28  
1966

From which

A 24 inch Fir bears S15° 18' W 70.6 feet dist. with scribe on partially healed face  
A 12 inch Fir bears N22° 27' W 53.0 feet dist. with scribe on partially healed face  
A 13 inch Fir bears N27° 30' E 11.0 feet dist. unopened  
A 22 inch Cedar bears S8° 50' E 56.6 feet dist. marked T35SR3ES28BT  
A down Firstub bears S72° 30' W 10.0 feet dist. marked T35SR3ES29BT

One-quarter corner common to Sections 21 and 28 T35S R3E W.M.  
At the corner location I found a standard BLM monument ( unoffical at this time ) marked:

T35S R3E  
S21  
S28  
1978

From which

A 12 inch Pine bears N28° 03' E 62.9 feet dist. marked  $\frac{1}{4}$ S21BT  
A 14 inch Fir bears S45° 57' W 26.7 feet dist. marked  $\frac{1}{4}$ S28BT

Section corner common to Sections 21,22,27, and 28 T35S R3E W.M.  
At the corner location I found a standard BLM monument ( unoffical at this time ) marked:

T35S R3E  
S21|S22  
S28|S27  
1977

From which trees recorded in survey #2704

A 14 $\frac{1}{2}$  inch Pine bears N9° 27' E 32.7 feet dist. unopened  
An 18 inch Pine bears N23° 19' W 46.8 feet dist. unopened  
A 19 inch Fir bears S 69° 00' W 46.8 feet dist. unopened  
A 14 inch Pine bears S 4° 14' E 5.8 feet dist. unopened  
A decayed Fir stump bears S48° 09' E 14.0 feet dist. with partial scribes remaining  
A Fir chunk lying on ground bears N86° 43' E 4.55 feet dist. marked BT

One-quarter corner common to Sections 27 and 28 T35S R3E W.M.  
At the corner location I found a standard BLM monument ( unoffical at this time ) marked:

SURVEY NARRATIVE TO COMPLY WITH  
PARAGRAPH 209.250 OREGON REVISED STATUTES

SURVEY FOR: CHARLES R. LEWIS SR.  
6262 FISH LAKE RD.  
BUTTE FALLS, OREGON  
97522

EMIL O. HILLIG  
432 S. HARBOR BLVD. #128  
SANTA ANNA, CALIF.  
92704

RUSSELL SINCLAIR  
6210 FISH LAKE RD.  
BUTTE FALLS, OREGON  
97522

GEORGE NUNES  
P.O. BOX 232  
BUTTE FALLS, OREGON  
97522

LOCATION: West half of the Northwest one-quarter Section 28 Township 35 South  
Range 3 East Willamette Meridian, Jackson County Oregon

PURPOSE: To establish property corners for Charles Lewis, Emil Hillig,  
Russell Sinclair, and George Nunes.

PROCEDURE: Ran theodolite and EDM closed travers around exterior of section  
tying section and quarter section corners. Some of the BLM corners  
are not official at this time, these corners were checked and  
found to be set within the tolerances set forth in the 1973 BLM  
Manual of Surveying Instructions. The South line of the Butte  
Falls-Fish Lake Road right of way was established from a tie to  
the corner common to Sections 21, 22, 28, and 29. Ran interior  
lines closing to the exterior lines and set pins as shown on  
attached map.

CORNERS ACCEPTED FOR CONTROL:

One quarter corner common to S28 and S29 T35S R3E W.M. At the  
corner location I found a 2½" bronze disc on a ¾" C.I. pipe  
marked:

Jackson County  
T35S R3E  
¼ S  
|  
29 ---|--- 28

From which  
A 7½ inch Cedar bears N74° 50' E29.2 feet dilt. marked ¼ S28 BT  
A 5 inch Cedar bears S59° 04" W 13.0 feet dist. marked ¼ S29 BT  
An 11 inch Fir bears S23° 45' W 22.5 feet dist. marked CS BT  
Remains of original bearing tree bears N78° 28' W18.4 feet dist.  
marked B on overgrowth

North one-sixteenth corner common to S28 and S29 T35S R3E W.M.  
At the corner location I found a standard BLM monument ( unofficial  
at this time ) marked: