

N.E. CORNER D.L.C. NO. 82

S89° 57' 00" E 660.05'

GARFIELD STREET

R/S NO. 2914

OAKDALE PARK ADDITION

R/S NO. 6474

LINCOLN AVENUE

S00° 06' 14" W

R/S NO. 7236

396.21'

REC 356.0'

50.03'

50.03'

50.03'

50.03'

53.03'

53.03'

70.00'

70.00'

S89° 57' 01" E

S89° 57' 01" E

S89° 57' 02" E

S89° 57' 02" E

S89° 57' 03" E

S89° 57' 03" E

70.00'

70.00'

145.01'

145.01'

145.01'

145.01'

145.01'

(REC 145.0')

14

13

12

11

10

9

8

N00° 06' 18" E

396.20'

N00° 06' 30" E

KINGS HIGHWAY

20'

20'

20'

20'

20'

20'

20'

20'

20'

20'

BLOCK NO. 2

REGISTERED PROFESSIONAL LAND SURVEYOR

Richard L. Bath


MAP OF SURVEY LOCATED IN S.E. 1/4 of Sec 36, T37S, R2W, W.M. JACKSON COUNTY, OREGON FOR

DARKEN CONSTRUCTION CO. HOFFBUHR SURVEYING, INC. MEDFORD, OREGON

BY: RICHARD L. BATH RPLS NO. 1069 SCALE: 1" = 50' JUNE 21, 1979 BASIS OF BEARING: R/S NO. 6474 O = SET 5/8" x 24" IRON PIN ● = FD 5/8" IRON PIN (79-028)

FD. 2 1/2" BRASS CAP FOR INITIAL POINT OF PROPOSED LINCOLN PARK SUBD.

JACKSON COUNTY RECEIVED JUN 22 1979 SURVEYOR

TL 502-506 372W 36DN

6282

6282

SURVEY NO. 7879

SURVEY NARRATIVE TO COMPLY WITH PARAGRAPH 209.250  
OREGON REVISED STATUTES

SURVEY FOR: Darken Construction Co.  
10 Crater Lake Avenue  
Medford, Oregon 97501


LOCATION: Southeast one-quarter (1/4) of Section 36,  
Township 37 South, Range 2 West, Willamette  
Meridian, Jackson County, Oregon

PURPOSE: To survey and monument Lots 8 - 12 in Block 2  
of Oakdale Park Addition to the City of Medford

PROCEDURE: Using Recorded Survey No. 6474 and 7236 as a basis  
for control on this survey, set monuments on a prorated distance  
as shown on attached map.

Basis of bearing--Recorded Survey No. 6474

June 22, 1979

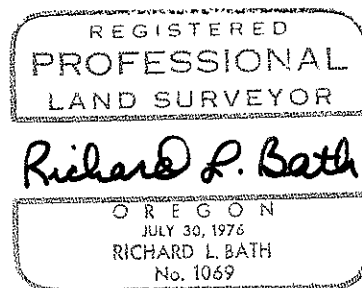

Richard L. Bath  
Hoffbuhr Surveying, Inc.