

MAP OF SURVEY

LOCATED IN ~ S.W. 1/4 SECTION 36, T.36 S., R.2 W., W.M.  
JACKSON COUNTY, OREGON

FOR ~ LEO F. LARSON AND DOROTHY B. LARSON  
164 1/2 VILAS ROAD WEST  
CENTRAL POINT, OREGON, 97502

BY ~ BURTON ENGINEERING & SURVEYING INC.  
44 S. 4TH ST.  
CENTRAL POINT, OREGON, 97502


DATE ~ JULY 5, 1979  
SCALE ~ 1" = 100'  
BASIS OF BEARING ~ SURVEY NO. 1915  
N 89°51'05" W  
LINE A-B

- FOUND IRON RODS
- SET 5/8 x 24 INCH IRON ROD

REGISTERED  
PROFESSIONAL  
LAND SURVEYOR

*Thomas H. Burton*

OREGON  
JANUARY 18, 1968  
THOMAS H. BURTON  
590

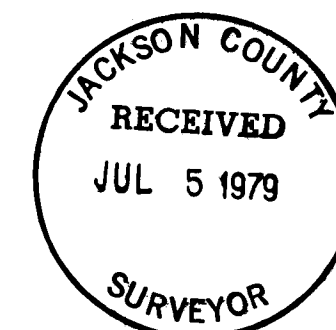

SURVEY No. 7903

SURVEY NARRATIVE

SURVEY FOR: LEO F. LARSON AND DOROTHY B. LARSON  
164 1/2 VILAS ROAD WEST  
CENTRAL POINT, OREGON, 97502

LOCATION: LOCATED IN SOUTHWEST 1/4 SECTION 36,  
TOWNSHIP 36 SOUTH, RANGE 2 WEST,  
OF THE WILLAMETTE MERIDIAN, JACKSON  
COUNTY, OREGON

PURPOSE: TO SURVEY, MONUMENT AND DESCRIBE THE  
LAND PROPERTY AS SHOWN ON THE ACCOM-  
PANYING MAP.

PROCEDURE: FOUND~


- Ⓐ 5/8" IRON ROD IN S.W. 1/16 SECTION CORNER  
SET BY SURVEY NO. 1915
- Ⓑ 5/8" IRON ROD SET BY SURVEY NO. 1915
- Ⓒ 3/4" IRON ROD SET BY SURVEY NO. 2459
- Ⓓ 3/4" IRON ROD SET BY SURVEY NO. 2459;  
0.15 FEET SOUTH OF BEARING LINE
- Ⓔ 1" IRON PIPE SET BY SURVEY NO. 315
- Ⓕ 1" IRON PIPE SET BY SURVEY NO. 315;  
0.07 FEET EAST OF LINE Ⓙ-Ⓔ
- Ⓖ 1" IRON PIPE SET BY SURVEY NO. 315

USED Ⓐ-Ⓑ LINE FOR BASIS OF BEARING AND  
THRU Ⓔ ON BEARING N 0°08'40"W INTERSECTED  
THE BEARING LINE TO ESTABLISH THE WESTERLY  
AND NORTHERLY PROPERTY LINES; THEN PRO-  
PORTION OF BEARINGS FROM SURVEYS NUMBER  
1915 AND 315 FOR EASTERLY AND SOUTHERLY  
PROPERTY LINE BEARINGS.

REGISTERED  
PROFESSIONAL  
LAND SURVEYOR

*Thomas H. Burton*

OREGON  
JANUARY 18, 1963  
THOMAS H. BURTON  
590

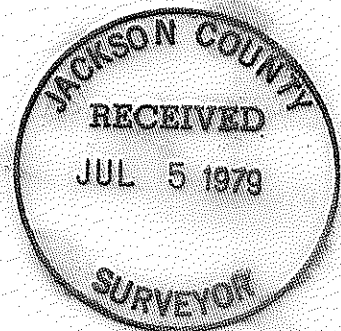

TRCS R2W, 36C (TL2700)