


BASIS OF BEARINGS: R.S. NO. 1961

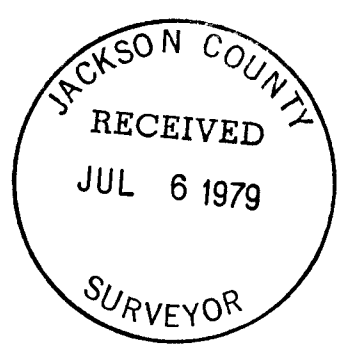

SURVEY FOR: WEST WRIGHT	
LOCATION: SW 1/4 SEC. 2, T. 37 S., R. 4 W.W.M. JACKSON COUNTY, OREGON	
DATE: JULY 6, 1979	
SCALE: 1" = 100'	REGISTERED PROFESSIONAL LAND SURVEYOR <i>Darrel W. Edwards</i> OREGON JULY 8, 1968 DARREL W. EDWARDS 741
● MONUMENTS FOUND	
○ 5/8" STEEL PINS SET	
( ) RECORD MEASUREMENT	

(T. 3100) 37 4 W 2

SURVEY NO. 7906

SURVEY NARRATIVE TO COMPLY WITH PARAGRAPH 209.250, OREGON REVISED STATUTES.

SURVEY FOR: West Wright  
2140 Footh Creek Road  
Hogue River, Or. 97537


LOCATION: SW 1/4 Sec.2, T. 37 S., R. 4 W.W.M.  
Jackson County, Oregon.

PURPOSE: To re-establish North and South lines of  
Lot 5 as shown in R.S. No. 1961.

PROCEDURE: Found 2" Initial Corner as set in R.S. No. 1961  
by Robert M. Thompson. Found Brass Cap, 1/4  
Corner, between Sections 2 and 11. Found or  
set pins as shown on accompanying plat.

BASIS OF BEARINGS: R.S. 1961

DATE COMPLETED: July 6, 1979.

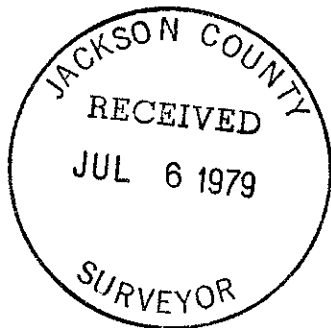

Darrel W. Edwards  
5721 Rogue River Hwy.  
Gold Hill, Oregon 97525  
Phone: 582-3110

REGISTERED  
PROFESSIONAL  
LAND SURVEYOR

*Darrel W. Edwards*  
OREGON  
JULY 8, 1966  
DARREL W. EDWARDS  
741