







P.A. NO. 79-14  
City of Ashland

# MINOR LAND PARTITION

Located in  
The SE1/4 SW1/4 NW1/4 & NW1/4 SW1/4  
Sec. 14, T39S, R1E

For  
Leland Cooley 700 Helman St. Ashland, Or.

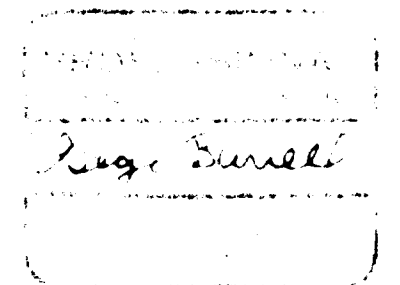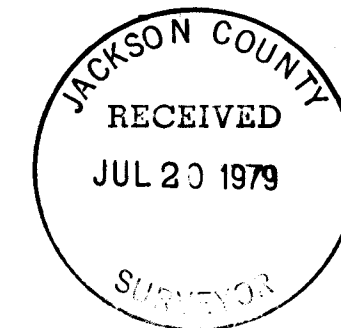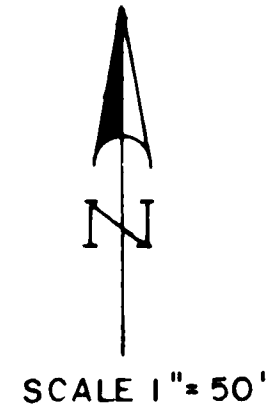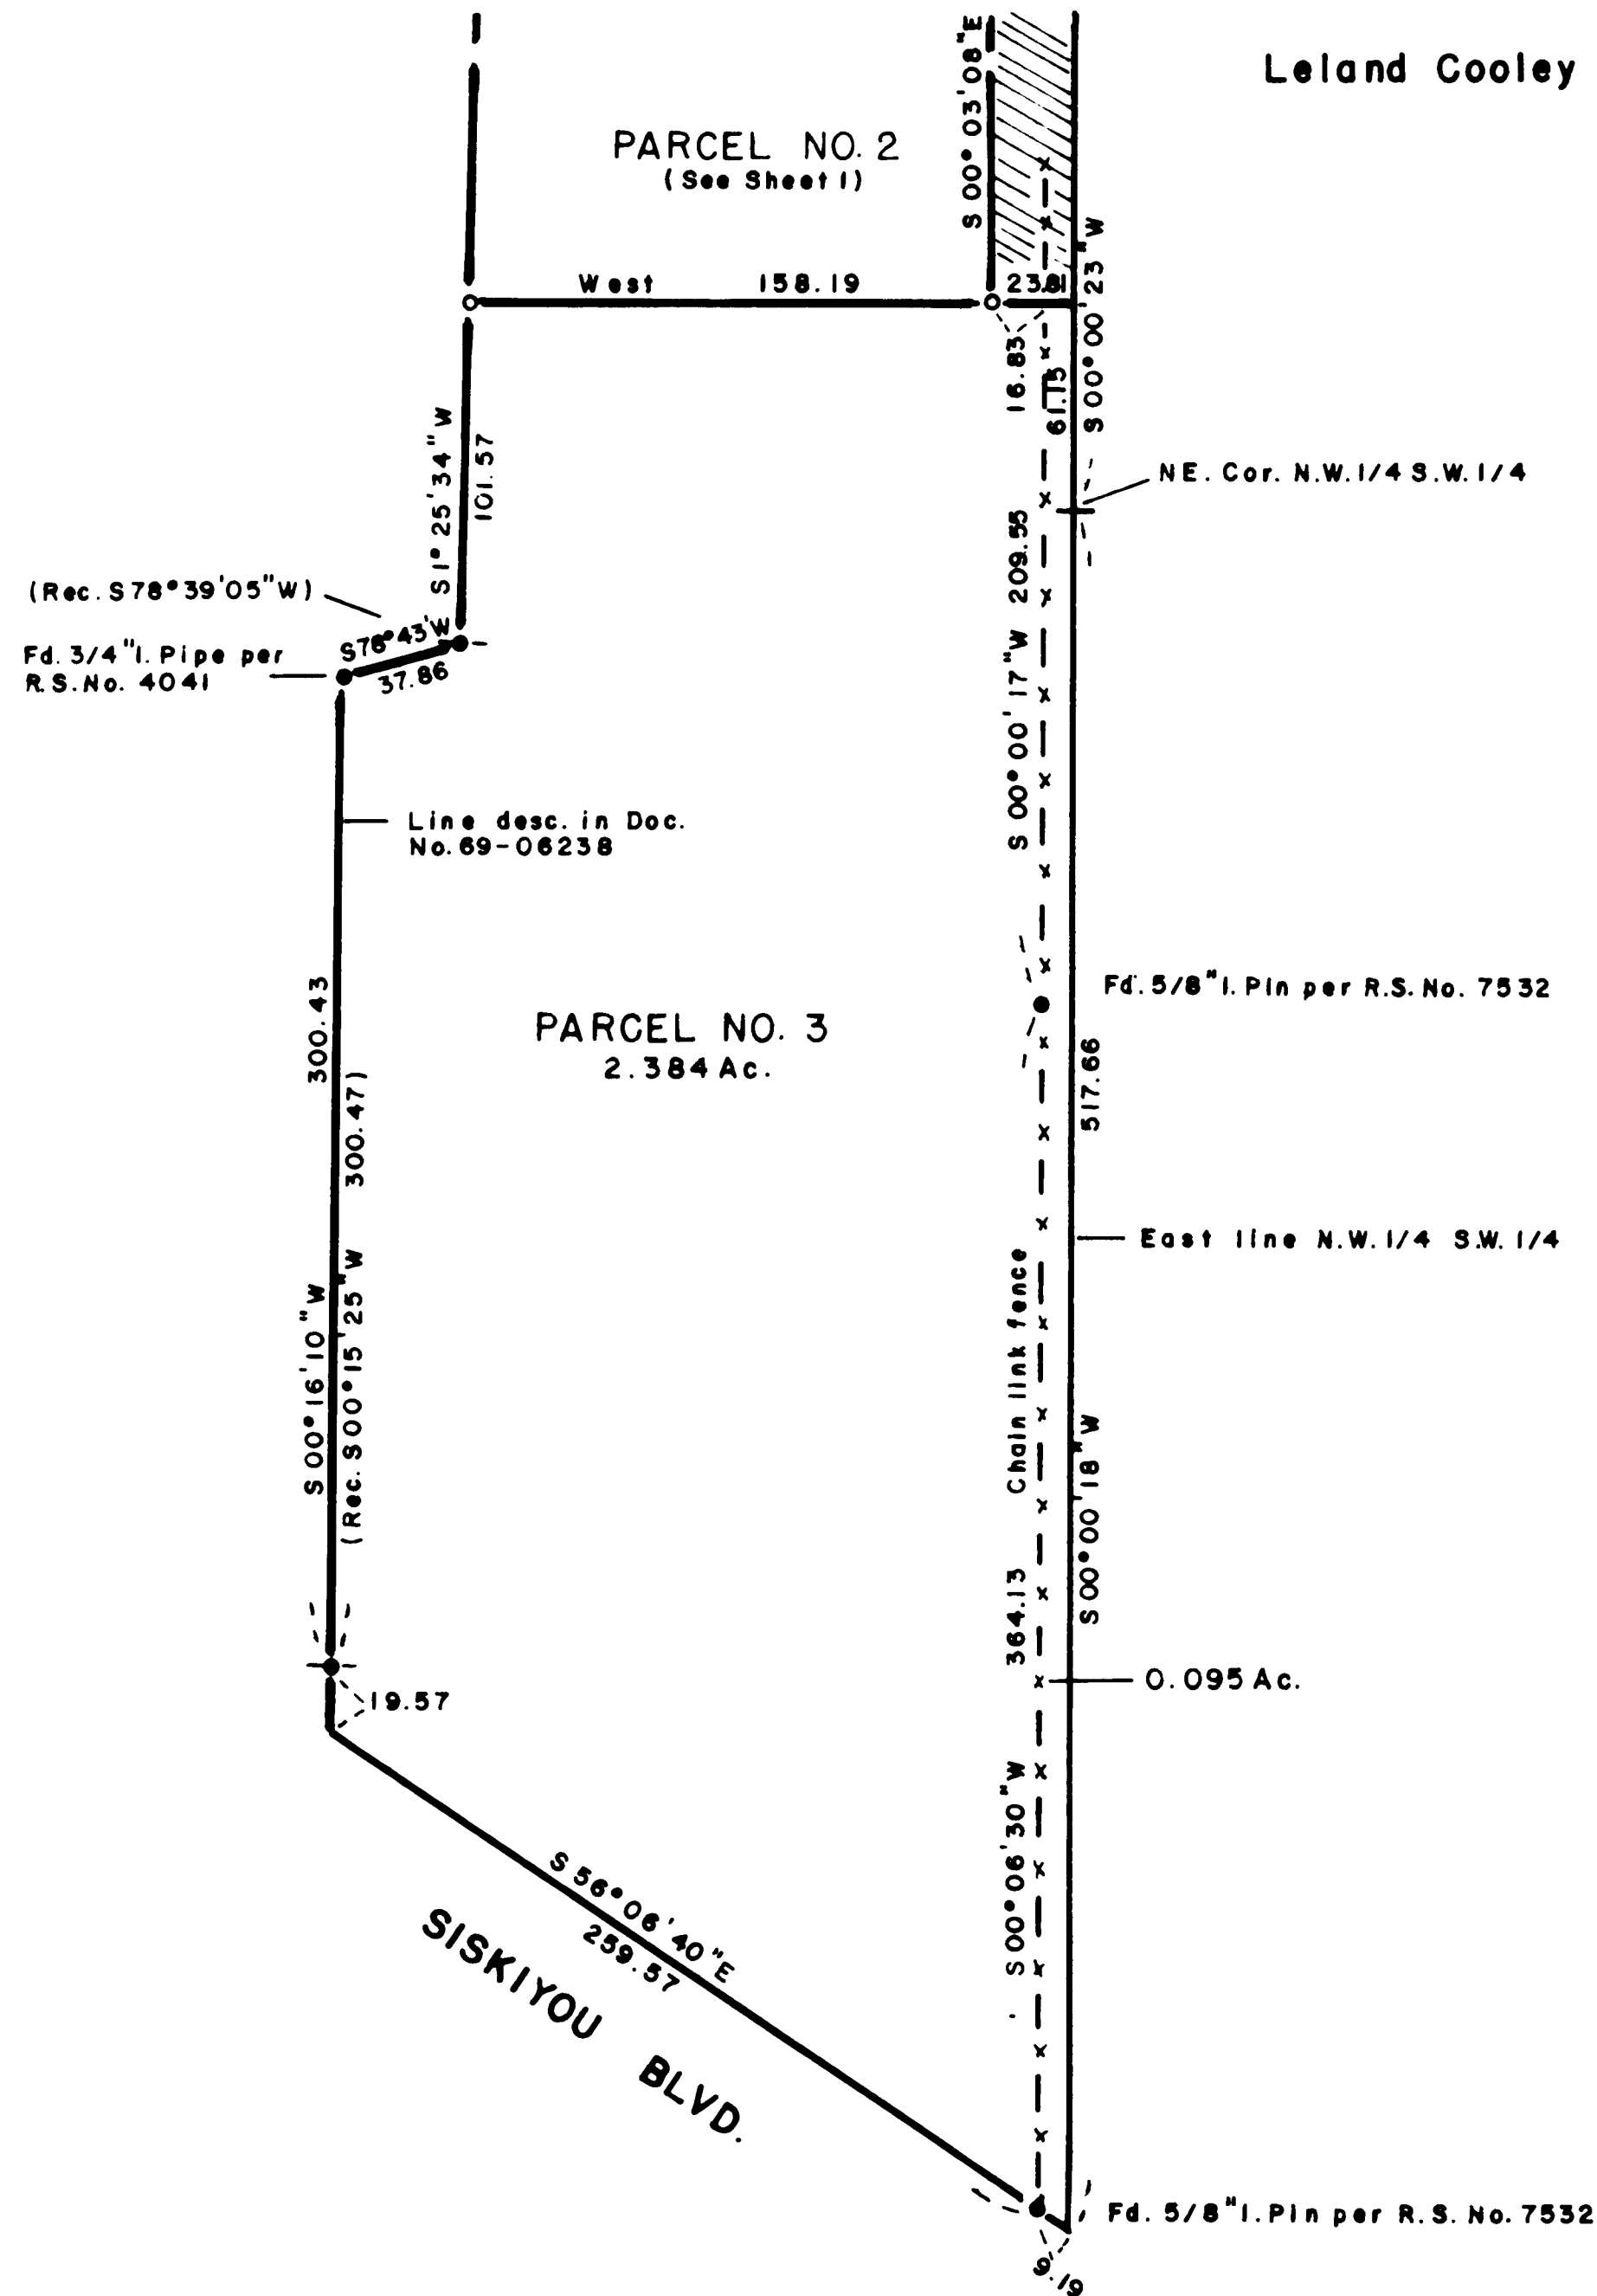

7915