


History of original corner establishment:

Surveyed by Turner & Howard under Contract No. 142 dated 1870. North on East boundary of Section 12, T. 41 S., R. 4 E., W.M., 40.00 chains. Set a post, from which:

- A 16" Yellow Pine bears S 67° W, 87 links
- A 12" Yellow Pine bears N 82° E, 114 links

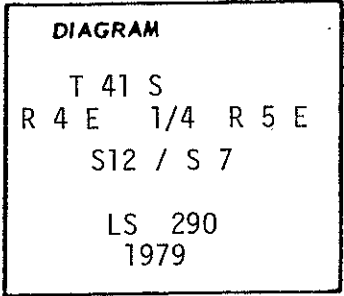

Description of corner evidence found:

Lyle & Helen Smith, 7/12/79. Found B.L.M. location tag on Jackson - Klamath County sign post on rocky road about 600' North of corner. Found both bearing trees --- S.W. is down & rotted 16" Pine with visible B.T. face. N.E. is short remnants of stump. Corner is 100' South of Power line and 8' East of fence corner (fence runs South and West only).

Description of monument and accessories I established to perpetuate the original location of this corner

Set 1"x36" galvanized iron pipe with 2" brass cap stamped as shown above, 12" in extremely rocky ground with mound of rock to support the pipe. Monument set by distance from the center of the original bearing trees, from which:

- 16" down Pine B.T. bears S 70° W, 57.4 feet.
- 12" B.T. Pine stump bears N 77° E, 75.2 feet.

- A 10" Juniper bears S 52°E, 47.5 feet scribed 1/4 S7 CSBT.
- A 9" Juniper bears S83°W, 34.0 feet scribed 1/4 S12 CSBT.

Bearings are by compass with 19° Mag. Var. Distances are to a nail in the base of the trees. USFS B.T. tags placed on both trees and scribed painted with red paint.

Office of _____ County Surveyor _____ Klamath County of _____
 State of _____ Oregon _____, I hereby certify that the within Instrument was filed in this office
 for record on the 23rd day of July, 1979.
 _____ by _____
 (COUNTY OFFICIAL) (DEPUTY)

