


MAP OF SURVEY  
FOR  
**MR. RICHARD E. TIBBETS**  
LOCATED IN  
SEC. 20, T. 37 S., R. 2 W., W. M.  
JACKSON CO., OREGON  
JULY 28, 1979

LEGEND  
 • FOUND 5/8" DIA. IRON PIN  
 ○ SET 5/8" DIA. X 24" LG. IRON PIN  
 ⊙ D.L.C. MONUMENT  
 SCALE 1"=100'  
 BASIS OF BEARING-RS. 1535

SURVEYED BY  
HAROLD L. CENTER P.L.S.  
MEDFORD, OREGON

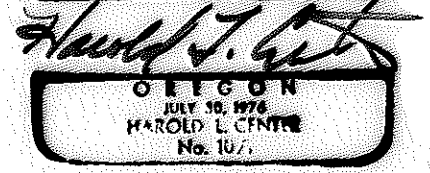

SURVEY NARRATIVE TO COMPLY WITH  
PARAGRAPH 209.250 OREGON REVISED STATUTES

SURVEY FOR: Mr. Richard E. Tibbets  
1545 Old Stage Road  
Medford, Oregon 97501

LOCATION: Parcel situated within Section 20,  
Township 37 South, Range 2 West,  
Willamette Meridian, Jackson County,  
Oregon.

BASIS OF BEARING: Record Survey No. 1535

PURPOSE: To monument the parcel as shown on  
the attached map of survey.

PROCEDURE: Before commencing this survey, it was  
explained to the client that the west  
property boundary is the west line of  
government lot 6 and that extensive  
survey would be required for proper  
establishment of that line. It was  
decided that for the purpose of this  
survey that existing fence line would  
be monumented. Utilizing warranty  
deed and surveys of record, previously  
established monuments were recovered  
and the parcel was monumented as shown.

Harold L. Center  
Registered Professional Land Surveyor  
Oregon Certificate No. 1071

