

MAP OF SURVEY  
 LOCATED IN  
 SEC. 28 T35S R3E., W.M.  
 JACKSON CO. OREGON  
 FOR


ROGUE RIVER NAT. FOREST

MEAN MAG. DEC. 19 1/2° E

BASIS OF BEARING—SOLAR OBSERVATION

SCALE: 1" = 500'

- FOUND BLM BRASS CAP
- FOUND UNOFFICAL BLM BRASS CAP
- FOUND C.S. BRASS CAP
- SET 2 1/2" DIA. X 30" LG. IRON POST WITH 2 1/2" DIA. BRASS CAP
- ⊕ SET 2 1/2" BRASS DISC IN BASALT STONE
- ⊕ FOUND 5/8" X 30" REBAR WITH 1 1/2" ALUM. CAP

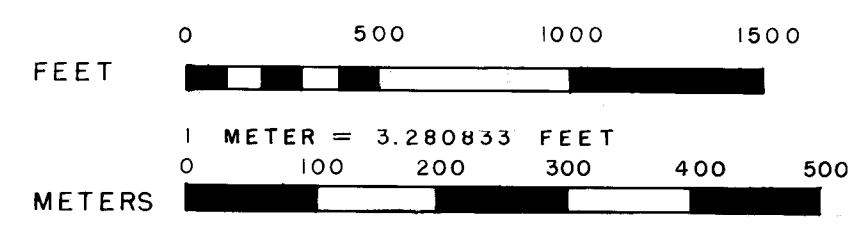



**CERTIFICATE OF SURVEY**

I, ARTHUR R. RAMBO REGISTRATION N° 1086 REGISTERED PROFESSIONAL LAND SURVEYOR STATE OF OREGON, HEREBY CERTIFY THAT THIS MAP CORRECTLY REPRESENTS A SURVEY MADE BY ME IN CONFORMANCE WITH THE LAWS OF THE STATE OF OREGON, AND WITH THE ARTICLES OF MY CONTRACT.


*Arthur R. Rambo*

ARTHUR R. RAMBO  
 REGISTERED LAND SURVEYOR  
 OREGON LICENSE N° LS-1086

DATE: 16 AUG 79

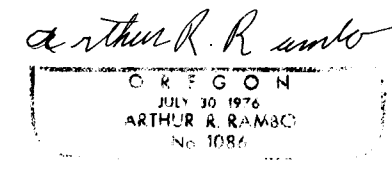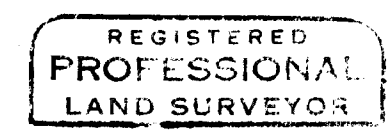

EXAMINED & ACCEPTED FOR THE  
 U.S. FOREST SERVICE  
 THIS 17<sup>th</sup> DAY *August*, 1979.  
*Howard J. Galt, P.E.* C.O.R.

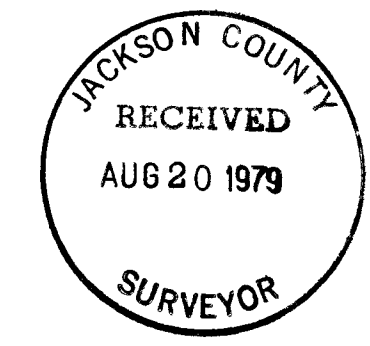

Center West 1/16 corner Section 28 T35S R3E W.M. At the corner location I found a  $1\frac{1}{2}$  inch dia. Alum. cap on a  $\frac{5}{8}$  inch dia. rebar marked:

LS1086  
S28  
CW1/16- $\frac{1}{2}$

T35S R3E

From which

A 7 inch dia. Fir bears N2° 28'W 38.5 feet marked CW1/16S28 LS1086BT  
A 6 inch dia. Fir bears S14° 08'W 23.6 feet marked CW1/16S28 LS1086BT

CORNERS SET THIS SURVEY

Center one quarter corner Section 28 T35S R3E W.M. At the corner location I set a  $2\frac{1}{2}$  inch dia. iron post with a  $2\frac{1}{2}$  inch dia. brass cap marked:

LS1086  
C $\frac{1}{4}$   
S28- $\frac{1}{2}$   
T35S R3E  
1979

From which



A  $12\frac{1}{2}$  inch dia. Fir bears N36° 23'W 12.5 feet marked C $\frac{1}{4}$ S28 BT with a  $\frac{1}{2}$  inch dia. washer marked LS1086 nailed to lower face  
A 6 inch dia. Fir bears S54° 48'W 23.6 feet marked C $\frac{1}{4}$ S28 BT with a  $\frac{1}{2}$  inch dia. washer marked LS1086 nailed to lower face

Center South one sixteenth corner Section 28 T35S R3E W.M. At the corner location I set a  $2\frac{1}{2}$  inch dia. brass disc in a basalt stone marked:

LS1086  
CS1/16  
S28  $\frac{1}{2}$   
T35S R3E  
1979

From which

An 11 inch dia. Fir bears N17° 45'W 31.8 feet marked CS1/16S28 BT with a  $\frac{1}{2}$  inch dia. washed marked LS1086 nailed to lower face  
A 9 inch dia. Fir bears S86° 58'E 76.4 feet marked CS1/16S28 BT with a  $\frac{1}{2}$  inch dia. washer marked LS1086 nailed to lower face

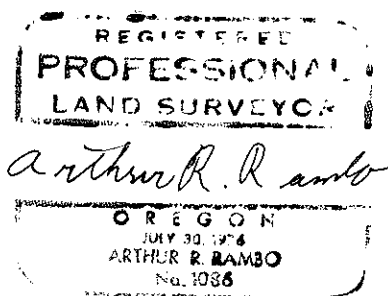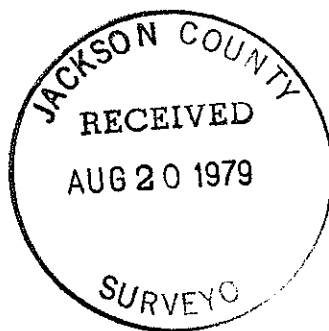

South one sixteenth corner common to Sections 27 and 28 T35S R3E W.M.  
At the corner location I found a standard BLM monument  
(unrecorded) marked:

T35S R3E  
S1/16  
S28|S27  
1977

From which

A 16 inch dia. Fir bears S57° 38'W 55.8 feet marked S1/16S28BT  
A 15½ inch dia. Pine bears S69° 18'E 24.1 feet marked S1/16S27BT

Section corner common to Sections 27,28,33, and 34 T35S R3E W.M.  
At the corner location I found a standard BLM monument marked:

T35S R3E  
S28|S27  
S33|S34  
1962

From which

A 15 inch dia. Fir bears S76° 16'E 21.4 feet unopened  
A 22 inch dia. Fir bears N5° 31'E 10.6 feet unopened  
A 18 inch dia. Fir bears N45° 19'W 8.5 feet unopened  
A 20 inch dia. Fir bears S13° 29'W 44.4 feet unopened  
A 2" inch dia. Fir bears S47° 41'E 31.4 feet unopened (CS tree)  
A 24½ inch dia. Fir bears N45° 19'W 34.5 feet unopened (CS tree)

East one sixteenth corner common to Sections 28 and 33 T35S R3E W.M.  
At the corner location I found a standard BLM monument  
(unrecorded) marked:

T35S R3E  
S28  
E1/16-----  
S33  
1977

From which

A 10 inch dia. Fir bears N29° 27'W 21.7 feet marked E1/16S28BT  
A 10 inch dia. Fir bears S0° 29' 30"W 48.8 feet marked E1/16S28BT

One quarter corner common to Section 28 and 33 T35S R3E W.M.  
At the corner location I found a standard BLM monument  
marked:

T35S R3E  
S28  
¼ -----  
S33  
1966

From which

A 15 inch dia. Fir bears N49° 58'E 37.4 feet unopened  
A 39½ inch dia. Fir bears N46° 04'W 5.6 feet unopened  
A 23 inch dia. Fir bears S69° 05'W 7.8 feet marked with  
4 in chopped out upper face  
A 14 inch dia. dead Fir bears S28° 13'W 31.1 feet marked ¼S33BT

Section corner common to Sections 28,29,32, and 33 T35S R3E W.M.  
At the corner location I found a standard BLM monument  
(unrecorded) marked:

T35S R3E  
S29|S28  
S32|S33  
1977

From Which

A 7½ inch dia. Fir bears S9° 52'E 17.5 feet marked T35SR3ES33BT  
A 10 inch dia. Fir bears S64° 00'W 28.4 feet marked T35SR3ES32BT  
A 14 inch dia. Fir bears N0° 20'E 63.3 feet marked T35SR3ES29BT  
A 10 inch dia. Fir bears N58° 00'E 27.5 feet marked T35SR3ES28BT  
A down Fir bears N44° 23'W 17.2 feet to stump hole (CS tree)  
A 9 inch dia. stump bears S11° 15'E 18.2 feet (CS tree)

Section corner common to Section 20,21,28, and 29 T35S R3E W.M.  
At the corner location I found a standard BLM monument marked:  
T35S R3E

$$\begin{array}{c} 20|21 \\ 29|28 \end{array}$$

1966

From which

A 24 inch dia. Fir bears S15° 18' W 70.6 feet with scribes  
on partially healed face  
A 12 inch dia. Fir bears N22° 27' W 53.0 feet with scribe  
on partially healed face  
A 13 inch dia. Fir bears N27° 30' E 11.0 feet unopened  
A 22 inch dia. Cedar bears S8° 50' E 56.6 feet marked T35SR3ES28BT  
A down Fir stub bears S72° 30' W 10.0 feet marked T35SR3ES29BT

One quarter corner common to Section 21 and 28 T35S R3E W.M.  
At the corner location I found a standard BLM monument  
(unrecorded) marked:

T35S R3E

$$\begin{array}{c} S21 \\ \frac{1}{4} \text{-----} \\ S28 \end{array}$$

1978

From which:

A 12 inch dia. Pine bears N28° 23' E 62.9 feet marked  $\frac{1}{4}$ S21BT  
A 14 inch dia. Fir bears S45° 57' W 26.7 feet marked  $\frac{1}{4}$ S28BT

Section corner common to Sections 21,22,27, and 28 T35S R3E W.M.  
At the corner location I found a standard BLM monument  
(unrecorded) marked:

$$\begin{array}{c} T35S R3E \\ S21|S22 \\ S28|S27 \end{array}$$

1977

From which trees recorded survey #2704

A 14 $\frac{1}{2}$  inch dia. Pine bears N9° 27' E 32.7 feet unopened  
An 18 inch dia. Pine bears N23° 19' W 46.8 feet unopened  
A 14 inch Pine bears S4° 14' E 5.8 feet unopened  
A 19 inch dia. Fir bears S69° 00' W 46.8 feet unopened  
ORIGINAL TREES  
A decayed Fir stump bears S48° 09' E 14.0 feet with partial  
scribe remaining  
A Fir chunk lying on ground bears N86° 43' E 4.55 feet  
marked BT

One quarter corner common to Sections 27 and 28 T35S R3E W.M.  
At the corner location I found a standard BLM monument  
(unrecorded) marked:

$$\begin{array}{c} T35S R3E \\ \frac{1}{4} \\ S28|S27 \end{array}$$

1977

From which

An 8 inch dia. Fir bears S79° 05' E 41.9 feet marked  $\frac{1}{4}$ S27BT  
An 11 $\frac{1}{2}$  inch dia. Fir bears N89° 24' W 10.8 feet marked  $\frac{1}{4}$ S28BT LS1086

Survey Narrative To Comply With  
Paragraph 209.250 Oregon Revised Statutes

SURVEY FOR: Rouge River National Forest  
P.O. Box 520  
Medford, Oregon 97501

LOCATION: Section 28, Township 35 South, Range 3 East,  
Willamette Meridian, Jackson County, Oregon

PURPOSE: To locate boundry lines of National Forest Land in said  
section.


HISTORY OF SURVEY:

Original surveys were performed by deputy surveyor Nathaniel Ford under contract No. 58 Date April 18, 1855. Controlling section and quarter section corners were remonumented by Jackson County in 1978 and by the Bureau of Land Management (BLM) in 1962 and 1966 and an unrecorded survey in 1977 and 1978 as noted in this narrative.

PROCEDURE: Ran theodolite and EDM closed traverse around exterior of section tying to section, quarter section, and sixteenth section corners. Some of the BLM corners are not official at this time, these corners were checked and found to be set within the tolerances set forth in the 1973 BLM Manual of Surveying Instructions and were accepted for control. Ran interior lines closing to exterior lines and set monuments as shown on attached map.

CORNERS ACCEPTED FOR CONTROL:


One quarter corner common to S28 and S29 T35S R3E W. M. At the corner location I found a 2 1/2" bronze disc on a 3/4" G.I. pipe marked:

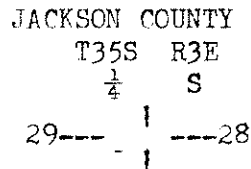

From which

A 7 1/2 inch dia. Cedar bears N74° 50' E 29.2 feet marked 1/4 S28 BT  
A 5 inch dia. Cedar bears S59° 04' W 13.0 feet marked 1/4 S29 BT  
An 11 inch dia. Fir bears S23° 45' W 22.5 feet marked CS BT  
Remains of original bearing tree bears N78° 28' W 18.4 feet marked B on overgrowth

North one-sixteenth corner common to S28 and S29 T35S R3E W.M. At the corner location I found a standard BLM monument (unrecorded) marked:

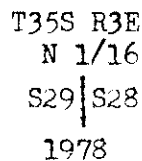

From which

A 6 inch Fir bears S22° 12' E 29.1 feet marked N1/16S28BT  
A 9 inch dia. Fir bears S57° 10' W 40.4 feet marked N1/16S29BT