

SURVEY IN BLOCK 9 OF PIERCE SUBDIVISION
(SW 1/4 SW 1/4 SEC. 21), T. 37 S., R. 1 W., W. M.,
CITY OF MEDFORD, JACKSON COUNTY, ORE.

FOR: JERRY FOX

SURVEY BY: CHARLES H. HURST
MEDFORD, OREGON

FD. R.R. SPIKE P.I. / SPRING ST.

SEE SURVEYS
5672 & 5780


R/W AS MONUMENTED

BROOKDALE AVENUE

N 0°00'50"E

N 0°06'35"W

FD. 1" IRON PIPE
SW COR. SEC. 21 BRG.
S 89°49'10"W 631.70' &
S 0°01'13"E 982.52'

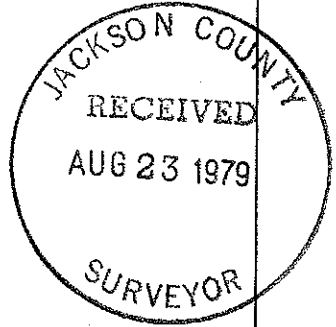

REGISTERED
PROFESSIONAL
LAND SURVEYOR

Charles H. Hurst

OREGON
OCTOBER 30, 1959
CHARLES H. HURST
483

AUG 8 1979

FD. 1" IRON PIPE

FD. 1" IRON PIPE

N 89°49'10"E
AGREEMENT LINE PER OR 75-14961

S 75°04'55"W
295.89'

N 75°04'55"E
176.90'

20.67'
25.67'

25.00'
37.99'

S 0°06'35"E 190.47'
REC. 190.53'


N 0°06'35"W 190.47'
REC. 190.53'

0.493 ACRES

LEGEND

- SET 5/8" X 24" IRON PINS
- FOUND 5/8" IRON PINS

SCALE: 1" = 50'

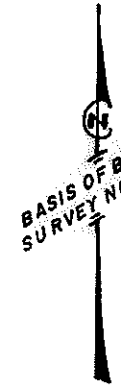

N 89°49'10"E
115.00'

SURVEY 6814

(TL 3100) 371W 21C

SURVEY NARRATIVE TO COMPLY WITH PARAGRAPH 209.250
OREGON REVISED STATUTES

7954

Survey for: Jerry Fox
3131 Capital Avenue
Medford, Oregon 97501

Survey by : Charles H. Hurst
304 South Holly
Medford, Oregon 97501

Bearings : Based on Survey No. 5227 (Section line).

Purpose : To locate an existing tax lot and monument the corners thereof.

Procedure : Extension of survey control previously established in the immediate vicinity.

The terminus of Brookdale Avenue was not established. However, the centerline thereof was held on the basis of Surveys 5672 and 5780 as shown on the plat for Survey 6959.

August 8, 1979

