


MAP OF SURVEY
LOCATED IN SECTION 33, T.37S., R.3E., AND SECTION 4, T.38S., R.3E., W.M., JACKSON COUNTY, OREGON.

FOR THE U.S. FOREST SERVICE

CONTRACT SURVEYOR'S CERTIFICATE:
I, KURT C. WEAVER, A REGISTERED PROFESSIONAL LAND SURVEYOR IN THE STATE OF OREGON, HEREBY CERTIFY THAT THIS PLAT AND THE NOTES HEREON, OR ATTACHED, ARE A CORRECT REPRESENTATION OF A SURVEY PERFORMED BY ME OR UNDER MY DIRECTION DURING JULY AND AUGUST, 1979 FOR THE U.S. FOREST SERVICE, IN ACCORDANCE WITH THE STATUTES OF THE STATE OF OREGON AND WITH THE ARTICLES OF MY CONTRACT.

Ref: CONTRACT NUMBER 53-04HI-9-7447N
BASIS OF BEARING: SOLAR OBSERVATION
① FD. BLM BRASS CAP AS SHOWN
② SET 2"x30" G.I. P.W./A 2 1/2" BRASS CAP MKD. AS PER THE B.L.M. MANUAL OF INSTRUCTIONS. 1 METER = 3.2808333 FT.
SCALE: 1" = 400'
REF: FIELD BOOK NO. 10F1, BIG CHARLIE CADASTRAL SURVEY, CONTRACT NO. 53-04HI-9-7447N
DATE: SURVEY BEGAN JULY 16, 1979 - COMPLETED AUGUST 6, 1979.

HISTORY:
THE SUBDIVISION OF T.37S., R.3E. WAS DONE BY WILLIAM M. TURNER IN 1883. THE B.L.M. SUBSEQUENTLY PERFORMED A DEPENDENT RESURVEY OF THE WEST LINE OF SECTION 33, SETTING THE WEST 1/4 CORNER ON A PROPORTION BASIS AND THE NORTH 1/16. CHARLES HURST, P.L.S. 483, SUBDIVIDED THE NW 1/4 OF SECTION 33, SETTING THE C 1/4, N.W. 1/16, THE N 1/4 CORNER ON A PROPORTION BASIS AND THE WEST 1/16 ON THE NORTH LINE. THIS SUBDIVISION WAS DONE ON FILED SURVEY NO. 6503 IN 1976.

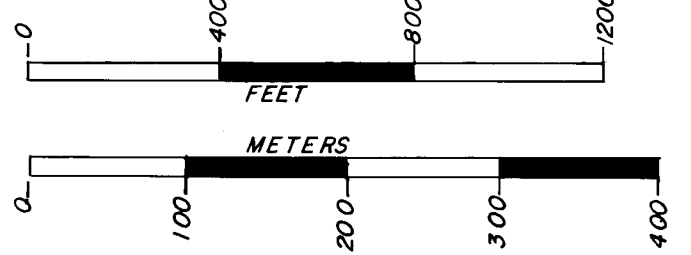

REGISTERED PROFESSIONAL LAND SURVEYOR

Kurt C. Weaver
OREGON JULY 14, 1978 KURT C. WEAVER 1679



Kurt C. Weaver
KURT C. WEAVER REGISTERED PROFESSIONAL LAND SURVEYOR OREGON LICENSE 1679

EXAMINED AND ACCEPTED FOR THE U.S. FOREST SERVICE THIS 31st DAY OF August 1979.

1/4 S4 and S3, T38S, R3E

Found Standard BLM pipe and B.C. from which:
 A stump hole bears N41°52'E 9.1 (rec. N50E 7.9 ft.)
 A D. Fir 14" dia. bears N 39°07'W 41.2 ft.
 (rec. N 37°W 40.9 ft.)
 A D. Fir 14" dia. bears S 70°33'E 7.6 ft.
 (rec. S 69°E 7.3 ft.)
 A D. Fir 35" dia. bears S 51°42'W 14.9 ft.
 (rec. S 51°W 14.5 ft.)


SURVEYED BY: T. Flatebo and Associates, Inc.
 P. O. Box 900
 Jacksonville, Oregon 97530

DATE: Survey began July 16, 1979
 completed August 6, 1979

REGISTERED
 PROFESSIONAL
 LAND SURVEYOR

Kurt C. Weaver

OREGON
 JULY 14, 1979
 KURT C. WEAVER
 1679

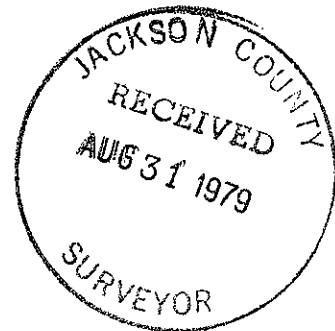

A D. Fir 13" dia. bears N 78°31'E 75.6 ft.
 (rec. N 78°E 75.2 ft.)
 A burnt Cedar stump 16" dia. bears S 66°25'E
 48.7 ft.
 (rec. S 67°E 48.1 ft.)
 A D. Fir 21" dia. bears S 30°27'E 70.4 ft.
 (rec. S 30°30'E 70.0 ft.)
 A D. Fir 22" dia. bears S26°56'W 29.4 ft.
 (rec. S 27°W 29.3 ft.)

1/4 Cor. S32 and S33, T37S, R3E

Found Standard BLM pipe and B.C. from which:

An I. Cedar 21" dia. bears S 61°41'E 22.2 ft.
 (rec. S 62°30'E 22.1 ft.)
 A D. Fir Snag 24" dia. bears N 72°30'W 19.9 ft.
 (rec. N 75°W 19.8 ft.)
 I mark the following tree 1/4 S32 BT and
 place a brass washer bearing my registration
 No. in the lower blaze:
 An I Cedar 17" dia. bears S22°47'W 31.7 ft.

N 1/16 Cor. S32 and S33, T37S, R3E

Found Standard BLM pipe and B.C. from which:

A D. Fir 20" dia. bears N 56°22'E 7.6 ft.
 (rec. N 56°E 7.6 ft.)
 A D. Fir 14" dia. bears S 56°01'W 26.4 ft.
 (rec. S 56°W 26.4 ft.)

NW 1/16 Cor. S33, T37S, R3E

Found 3/4" iron pin over which I set a 2" x 30"
 G.I.P. w/a 2 1/2" B.C. from which I find the
 following BT's:

A D. Fir 19" dia. bears N 51°17'W 27.9 ft.
 (rec. N 51°15'W 27.9 ft.)
 A D. Fir 13" dia. bears S 78°57'W 41.3 ft.
 (rec. S 78°45'W 41.8 ft.)

W 1/16 Cor. S28 and S33, T37S, R3E

Found 3/4" iron pin exposed 10" over which
 I set a 2" x 30" G.I.P. with a 2 1/2" B.C.
 from which I find the following BT's:

A W. Fir 15" dia. bears N 76°55'W 11.2 ft.
 (rec. N 77°15'W 11.1 ft.)
 A W. Fir 13" dia. bears S 10°52'W 52.6 ft.
 (rec. S 11°W 52.6 ft.)

C 1/4 Cor. S33, T37S, R3E

Found 3/4" iron pin exposed 4", over which
 I set a 2" x 30" G.I.P. with a 2 1/2" B.C.
 from which I find the following BT's:

A D. Fir 11" dia. bears N 13°03'E 39.3 ft.
 (rec. N 13°E 39.3 ft.)
 An I. Cedar 23" dia. bears S 5°39'E 18.4 ft.
 (rec. S 5°45'E 18.4 ft.)

A W. Fir 17" dia. bears S 16°01'W 81.2 ft.
 (rec. S 17°W 81.2 ft.)
 A Dead & Down Fir 14" dia. bears S 18°05'W
 147.4 ft.
 (rec. S 19°W 148.5 ft.)
 A W. Fir 20" dia. bears N 48°33'W 37.5 ft.
 (rec. N 47°W 37.6 ft.)
 A D. Fir 41" dia. bears N 31°39' W 97.1 ft.
 (rec. N31°W 95.7ft.)

1/4 Cor. S 33 & S 34, T37S, R3E

Found a 1" G.I.P. with a 2 1/2" Jackson
 County B.C. from which:

A W. Fir Stump 24" dia. bears N 51°35'E 18.8 ft.
 (rec. N52°E 18.8 ft.)
 A Stumphole of a dead & down D. Fir 8" dia.
 bears record N 83°E 11.8 ft.
 A W. Fir 9" dia. bears S 81°33'E 28.8 ft.
 (rec. S 85°30'E 28.9 ft.)
 A W. Fir snag 13" dia. bears S 70°29'W 15.2 ft.
 (rec. S 68°W 15.2 ft.)
 A D. Fir 28" dia. bears N 48°39'W 12.7 ft.
 (rec. N 51°W 13.1 ft.)

Sec. Cor. S27, S28, S33 & S34, T37S, R3E

Found Standard BLM pipe and B.C. from which:

A W. Fir 11" dia. bears N 40°49'E 20.4 ft.
 (rec. N 40°E 20.4 ft.)
 A D. Fir 33" dia. bears S 51°10'E 42.9 ft.
 (rec. S52°E 42.9 ft.)
 A W. Fir 22" dia. bears S 6°W 5.1 ft.
 (rec. S 6°W 5.2 ft.)
 A W. Fir Stump 19" dia. and 4 ft. high bears
 N 57°20'W 6.9 ft.
 (rec. N 66°W 7.9 ft.)
 A. W. Fir 10" dia. bears N 18°21'W 12.8 ft.
 (rec. N 18°W 12.5 ft.)
 A D&D Fir bears S 69°E 19.0 ft. (rec. S67°E 19.8)

1/4 Cor. S28 & S33, T37S, R3E

Found 3/4" iron pin with a 2 1/2" B.C. mkd.
 RS 483 from which:

A D. Fir 16" dia. bears N 55°09'E 14.6 ft.
 (rec. N 55°E 14.6 ft.)
 A D. Fir 18" dia. bears S 40°03'E 48.9 ft.
 (rec. S 40°E 48.5 ft.)

Sec. Cor. S 28, S29, S 32 and S33, T37S, R3E

Found Standard BLM pipe and B.C. from which:

A dead and down I. Cedar 20" dia. bears
 N 36°04'W 16.0 ft.
 (rec. N 35°W 15.8 ft.)
 A D. Fir 22" dia. bears N 11°02'W 45.9 ft.
 (rec. N 12°30'W 45.5 ft.)
 A dead and down I. Cedar 18" dia. bears
 N 56°08'E 35.0 ft.
 (rec. N 56°E 36.3 ft.)

SURVEY NARRATIVE TO COMPLY WITH O.R.S. 209.250

SURVEY FOR: U.S. FOREST SERVICE
 ROGUE RIVER NATIONAL FOREST
 P.O. BOX 520
 MEDFORD, OREGON 97501

LOCATION: Located in Section 33, Township 37 South, Range 3 East and Section 4, Township 38 South, Range 3 East of the Willamette Meridian, Jackson County, Oregon.

PURPOSE: To monument the center 1/4 and the Northwest 1/4 of the Northwest 1/4 of Section 33 and mark the lines with posts and blazing as shown on the accompanying map. I also mark the North half of the East line of Section 4.

PROCEDURE: Using a Wild T-2 theodolite and an H.P. 3805 A E.D.M. I tied all controlling corners and previously monumented interior corners via a series of closed traverses. After diligent search for the North and West 1/4 corners of Section 33 and verification of the monumented proportion positions, I accept the positions as no original evidence can be found and the monuments fit within prescribed limits.

I found or set the following monuments:

Sec. cor. S 32 & S33, T37S, R3E - S5 & S4, T38S, R3E

Found Standard BLM pipe and B.C. from which:
 A W. Fir 17" dia. bears N 41°42'E 22.6 ft.
 (rec. N41°30'E 22.7 ft.)
 A W. Fir 22" dia. bears S 46°06'E 49.1 ft.
 (rec. S46°30'E 48.8 ft.)
 A W. Fir 21" dia. bears S 86°34'W 31.5 ft.
 (rec. S 86°30'W 31.4 ft.)
 A W. Fir 22" dia. bears N 44°29'W 19.7 ft.
 (rec. N 45°W 19.8 ft.)

1/4 Cor. S33, T37S, R3E & S4, T38S, R3E

Found Standard BLM pipe and B.C. from which:
 A D. Fir 38" dia. bears N 19°38'W 51.2 ft.
 (rec. N 18°W 50.8 ft.)
 A D. Fir 48" dia. bears S 59°59'W 56.1 ft.
 (rec. S 61°W 55.4 ft.)

Sec. Cor. S33 & S34, T37S, R3E - S4 & S3, T38S, R3E

Found Standard BLM pipe and B.C. from which:
 A Twin W. Fir 35" dia. bears N 13°12'E 64.2 ft.
 (rec. N 14°E 64.7 ft.)
 A W. Fir 19" dia. bears N 80°08'E 80.6 ft.
 (rec. N 81°E 80.5 ft.)
 A W. Fir Stump 46" dia. bears S 63°10'E 98.7 ft.
 (rec. S 63°E 99.0 ft.)
 A.W. Fir 15" dia. bears S 5°42'E 94.1 ft.
 (rec. S 4°E 99.0 ft.)