

2982


SURVEY FOR HARRY WHITESIDES

In Lots 5 & 6, Block 3, DEKUM'S AMENDED ADD'N
GOLD HILL, OREGON
Section 16, T. 36 S., R. 3 W., W. M.
June 22, 1979

REGISTERED
PROFESSIONAL
LAND SURVEYOR

Verlyn Thomas



OREGON
MAY 13, 1960
VERLYN D. THOMAS
503

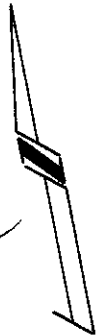

LEGEND

- Fd. Mon., as noted
- Set 5/8" X 24" I. Pin

SCALE: 1" = 50'

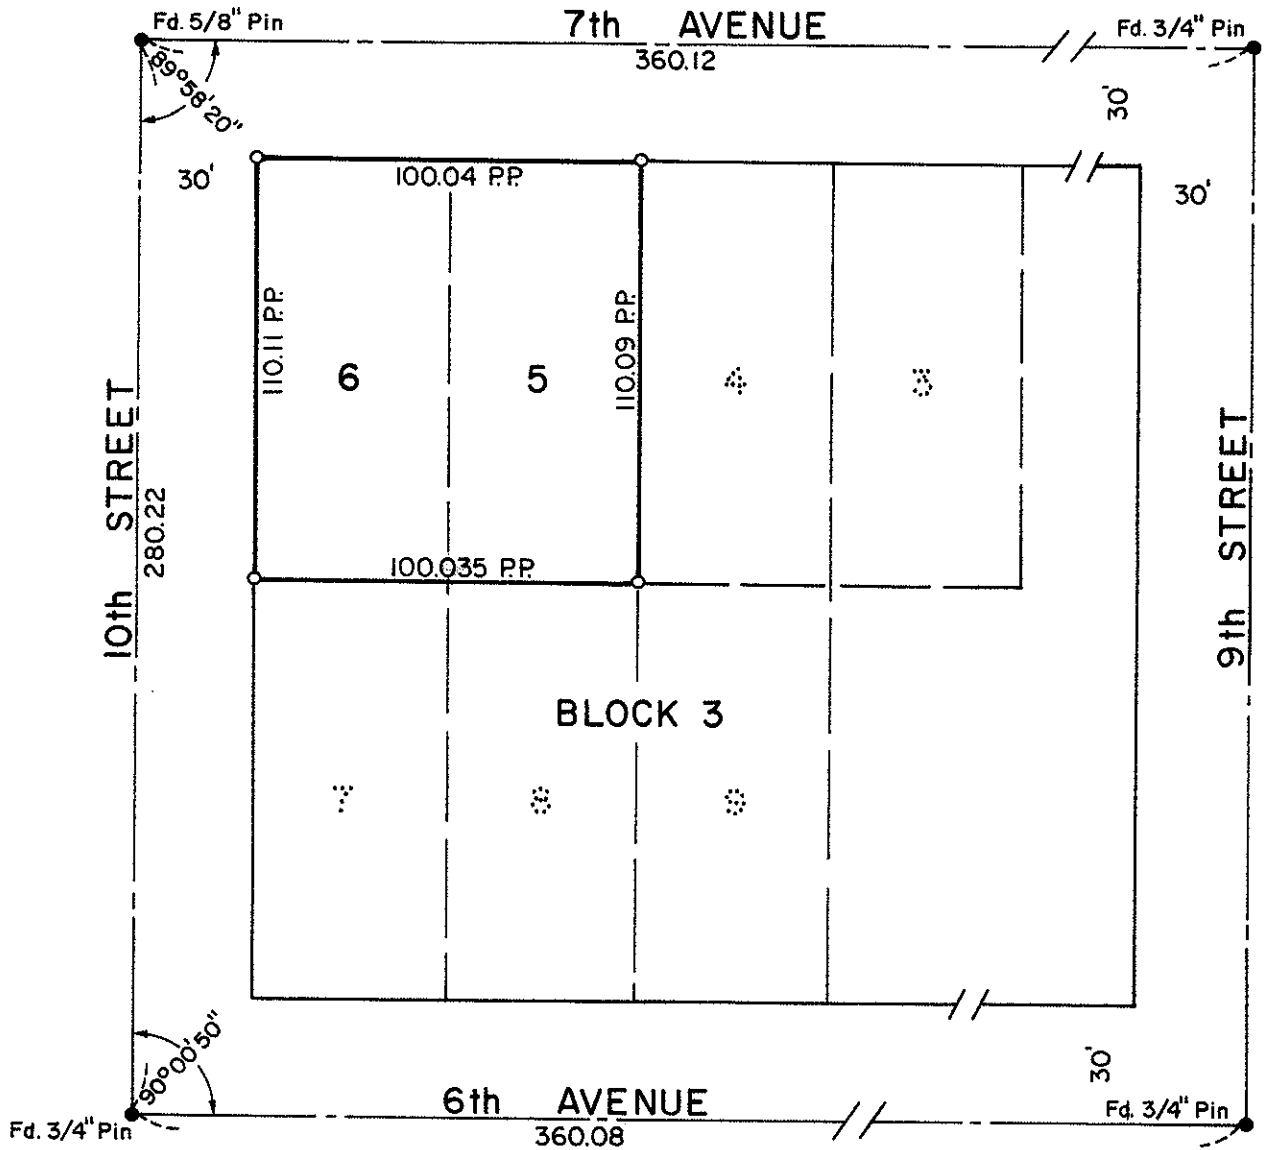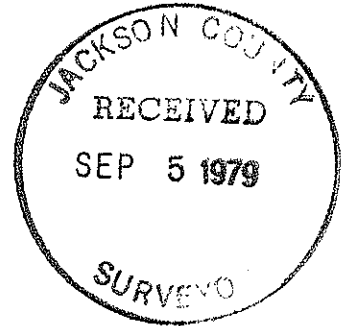

2982

SURVEY NO. 7982

SURVEY NARRATIVE TO COMPLY WITH O.R.S. 209.250

SURVEY FOR: Harry Whitesides
680 North Tenth Street
Gold Hill, Oregon

PURPOSE: To survey and monument Lots 5 and 6, Block 3, DEKUM'S
AMENDED ADDITION to Gold Hill.

PROCEDURE: Recovered street centers as established by previous surveys
of record, and determined pro-rate data from measurements
made in the field. Set lot corners as shown on accompanying
plat.

