


8035

# SURVEY FOR EMERY HAMILTON


In Lots 8 & 9, Block 2  
STAGE COACH HILLS SUB. UNIT NO. 3  
Jacksonville, Oregon  
September 19, 1979

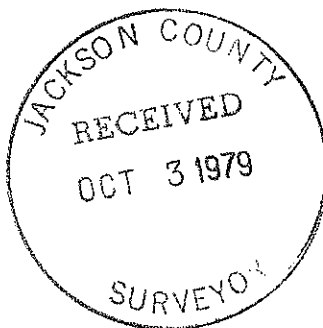

REGISTERED  
PROFESSIONAL  
LAND SURVEYOR

*Verlyn Thomas*


OREGON  
MAY 13, 1960  
VERLYN D. THOMAS  
505

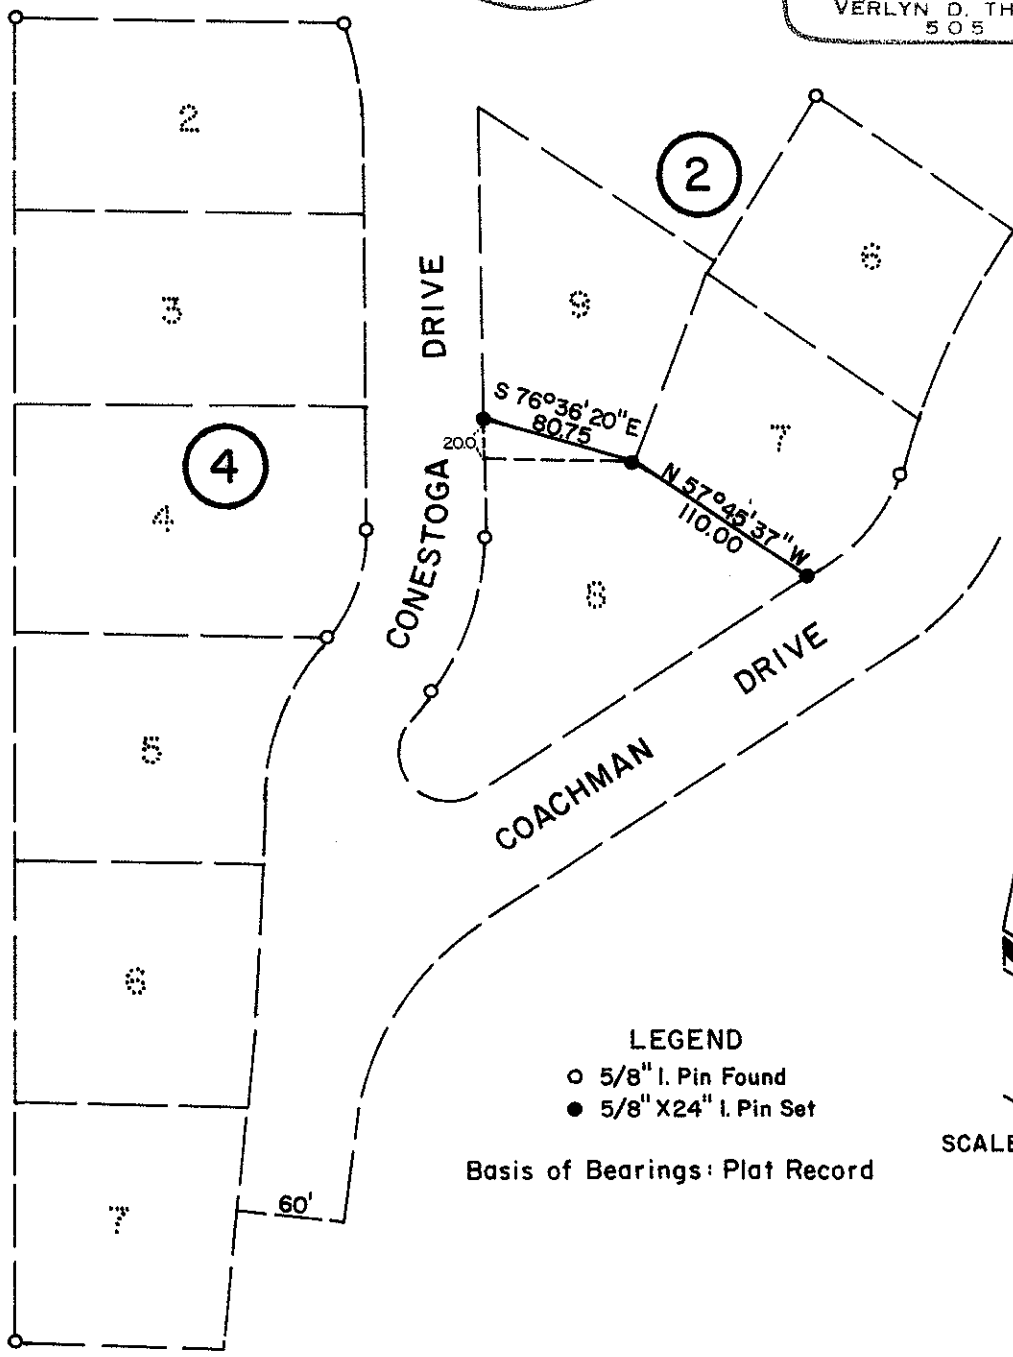

### LEGEND

- 5/8" I. Pin Found
- 5/8" X 24" I. Pin Set

Basis of Bearings: Plat Record

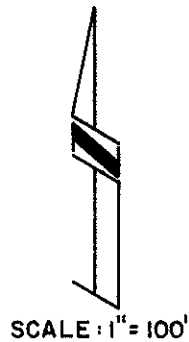

SCALE: 1" = 100'

8035

SURVEY NO. 8035

SURVEY NARRATIVE TO COMPLY WITH O.R.S. 209.250

SURVEY FOR: Emery Hamilton  
445 Conestoga Drive  
Jacksonville, Oregon

PURPOSE: To monument northerly line of client's parcel.

PROCEDURE: Apparently utility construction destroyed most of the original monuments in this subdivision. Therefore, a search was made for any existing lot corner monuments in the area from which the line in question could be determined. A random traverse was run, tying in these recovered monuments, and their relative location computed. These locations were compared with record computations, and an analysis made of the results. Final corner monuments were then set as shown on the accompanying plat.

