
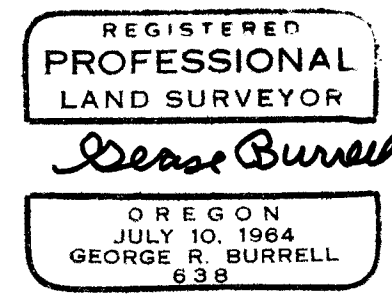


N.W. Cor. D.L.C. No. 49  
 Fd. br. capped pipe  
 per R.S. No. 6319  
 No BTs or Ref. fd.

N.E. Cor. D.L.C. No. 49  
 Fd. 1/2" pipe in rock md.

No BTs or Ref. fd.

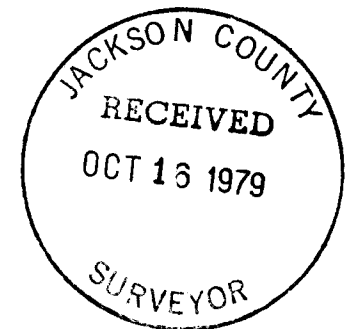

**MAP OF SURVEY**  
 Located in Bk. "G" ROGUE RIVER  
 VALLEY ORCHARD CO. TRACTS in  
 Sec. 32, Twp. 38 S, R1E W.M.  
 For: PAUL COMSTOCK & WM. AVE  
 By: Geo. Burrell, Surveyor 10/2/79

SURVEY NO. 8050

SURVEY NARRATIVE TO COMPLY WITH O.R.S.209.250

FOR: Paul Comstock and William Ave  
c/o Harry Skerry  
Attorney  
76 N. Pioneer  
Ashland, Oregon

PURPOSE: To monument and describe a common boundary for agreement purposes as directed by the client.

PROCEEDURE: Said boundary line was established on a line from the S.W. corner of Lot 8 to a position on the South R/W of Irish Lane as shown on the accompanying map. The control and proceedure of Recorded Survey No. 6695 was used in establishing said boundary.

