

SCALE 1" = 100'

Basis of Bearings R.S. No 5242

- = Fd. 5/8" I. Pin per R.S.No.5242
- = Set 5/8" X 24" I. Pin (tagged RLS.638)

19 20  
30 29 T 39S, R2E  
Fd. br. capped pipe  
per R.S. No. 5503

REGISTERED  
PROFESSIONAL  
LAND SURVEYOR  
*George Burrell*  
OREGON  
JULY 10, 1964  
GEORGE R. BURRELL  
638



**MAP OF SURVEY**  
Located in Section 19, Twp. 39S, R2E  
For: WILLIAM FROST  
By: Geo. Burrell, Surveyor, 10/22/79

SURVEY NO. 8064

SURVEY NARRATIVE TO COMPLY WITH O.R.S.209.250

FOR: William Frost  
11580 Corp Ranch Rd.  
Ashland, Oregon

PURPOSE: To monument a tract of record previously described by me.

PROCEEDURE: Using the found monuments of Recorded Survey No.5242 as control, said tract was monumented according to record.


The Section corner common to sections 19,20,29 and 30 was found as monumented and witnessed by Recorded Survey No. 5503. From the corner monument the bearing trees found are:

A 7" W.O. S 6° 42' W 14.11 feet  
A 9" W.O. N 81° 44' W 9.16 feet  
A 9" W.O. N 31° 48' E 86.67 feet  
A 7" W.O. S 81° 09' E 64.04 feet

REGISTERED  
PROFESSIONAL  
LAND SURVEYOR

*George Burrell*

OREGON  
JULY 10, 1964  
GEORGE R. BURRELL  
638

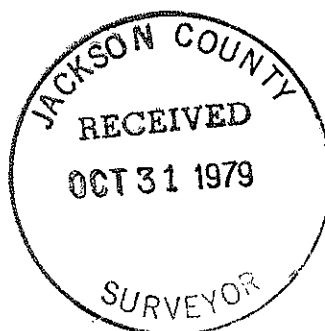

(TL 115, 120, 2100 & 2108)  
39 2E 19