

SURVEY FOR: JAMES SYMANSKI & JOE MOCHAL	
LOCATION: SW 1/4 & NW 1/4 SEC. 28, T. 34 S., R. 4 W. W.M. JACKSON COUNTY, OREGON	
DATE: OCT. 11, 1979	REGISTERED PROFESSIONAL LAND SURVEYOR
SCALE: 1" = 300	
5/8" STEEL PIN FOUND UNLESS OTHERWISE NOTED	<i>Darrel W. Edwards</i> OREGON JULY 2, 1974 DARREL W. EDWARDS 741
5/8" STEEL PIN SET	

SURVEY NO. 8080

SURVEY NARRATIVE TO COMPLY WITH PARAGRAPH 209.250, OREGON REVISED STATUTES.

SURVEY FOR: James Symanski and Joe Mochal  
4179 Ditch Creek Rd.  
Rogue River, Or. 97537


LOCATION: SW and NW 1/4's Sec. 28, T. 34 S., R. 4 W.W.M. in Jackson  
County, Oregon.

PURPOSE: To locate and monument property boundaries of three (3) five  
plus acre parcels and a 60 foot wide strip of land traded for  
a 40 foot wide strip of land. Said 40 foot strip being also  
a part of parcel number two. Set 5/8 " steel pins as shown on  
the accompanying plat.

BASIS OF BEARINGS: R.S. 7966

DATE COMPLETED: Oct. 11 1979

Darrel W. Edwards  
P.O. Box 801  
Rogue River, Oregon 97537  
Ph: 582-3110

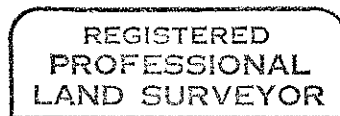

*Darrel W. Edwards*

