

MAP OF SURVEY

located in
 NW 1/4 OF SEC. 15, TWP. 39S., R. 1 E.W.M.
 JACKSON COUNTY OREGON

F. P. LOVERING

SWAIN SURVEYING, INC.

ASHLAND, OREGON

SCALE: 1"=40'

BASIS OF BEARING:

N.O.A.A. TRUE BEARING N-S & SEC. 15

- FOUND MONUMENT AS SHOWN
- SET 5/8 x 24 INCH IRON PIN TAGGED RLS 759

REGISTERED
 PROFESSIONAL
 LAND SURVEYOR
Everett L. Swain
 OREGON
 JULY 8, 1966
 EVERETT L. SWAIN
 759

JACKSON COUNTY
 RECEIVED
 NOV 28 1979
 SURVEYOR

ACCEPTED
 SW cor D.L.C. No. 45
 Fd. 2" I. Pipe

N. 89° 47' 22" W.
 N. 89° 47' 22" W. (Govt. Rec. West)

SE cor D.L.C. No. 45
 Fd. Br. Cap

SURVEY NO. 8112

SURVEY NARRATIVE TO COMPLY WITH PARAGRAPH 209.250
OREGON REVISED STATUTES



SURVEY FOR: F. P. Lovering
165 Van Ness Avenue
Ashland, Oregon 97520

LOCATION: Situated in the Northwest quarter of Section 15, Township 39
South, Range 1 East of the Willamette Base and Meridian, Jackson
County, Oregon.

PURPOSE: To survey and monument that tract of land as shown on the accompanying
map per clients request.

PROCEDURE: Expanded the survey control in this area and tied what unrecorded
monuments or purported monuments that could be found. After
researching the chain of title, proceeded to monument the subject
tract of land as shown on the accompanying map.

Swain Surveying, Inc.
Ashland, Oregon

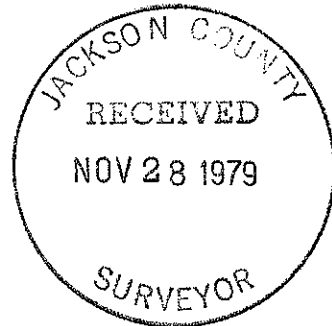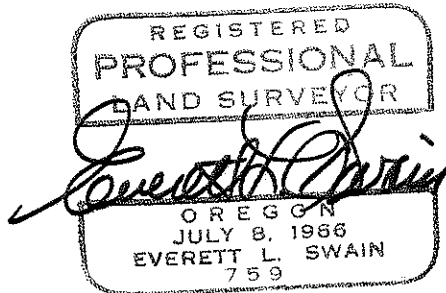

T39S.R1E.15BA (TL 3500)