

JACKSON COUNTY  
 RECEIVED  
 DEC 3 1979  
 SURVEYOR

<b>SURVEY FOR:</b> DENNIS DELISLE	
<b>LOCATION:</b> E. 1/2 SEC. 23, T. 36 S., R. 3 W.W.M. JACKSON COUNTY, OREGON.	
<b>DATE:</b> NOV. 19, 1979	<div style="border: 1px solid black; padding: 5px; text-align: center;">           REGISTERED            PROFESSIONAL            LAND SURVEYOR   <i>Darrel W. Edwards</i>            OREGON            JULY 9, 1963            DARREL W. EDWARDS            741         </div>
<b>SCALE:</b> 1" = 200'	
● MONUMENT FOUND	
○ 5/8" STEEL PIN SET	
( ) RECORD MEASUREMENT	
x-x-x-x-x FENCE LINE	

(TL 2300) 36 3w 23

SURVEY NO. 8116

SURVEY NARRATIVE TO COMPLY WITH PARAGRAPH 209.250, OREGON REVISED STATUTES.

SURVEY FOR: Dennis Delisle  
17215 Oak Leaf Dr.  
Morgan Hill, Ca. 95037

LOCATION: East 1/2 Sec. 23, T. 36 S., R. 3 W.W.M. in Jackson County, Oregon.


PURPOSE: To locate and monument property boundaries of 6.26 acre tract  
and prepare legal description of same.

PROCEDURE: Found monuments set in my survey No. 7447 and used these to set  
5/8" steel pins as shown on the accompanying plat.

BASIS OF BEARINGS: R.S. 7447

DATE COMPLETED: Nov. 19, 1979

Darrel W. Edwards  
P.O. Box 801  
Rogue River, Or. 97537  
Ph: 582-3110

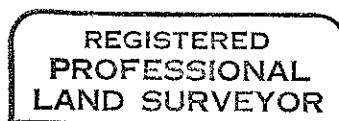

*Darrel W. Edwards*

