

SURVEY NO. 8151

SURVEY NARRATIVE TO COMPLY WITH O.R.S 209.250

DATE: 1979


FOR: A. W. Burgoyne
4107 Old Stage Road
Central Point, Oregon

PURPOSE: To survey and monument several parcels created through the county Minor Partition process.


PROCEDURE: Location of Tami Lane determined from monuments found and shown on the plan and profile plat for Tami Lane as obtained from the County, and the extension of Tami Lane as shown on the plat of TAMI LANE ESTATES. Additional monuments recovered and used in establishing the outside boundaries are as indicated on the accompanying plat.

Monumented parcels according to approved preliminary plats.

BASIS OF BEARINGS: East line LIVINGSTON HEIGHTS SUBDIVISION

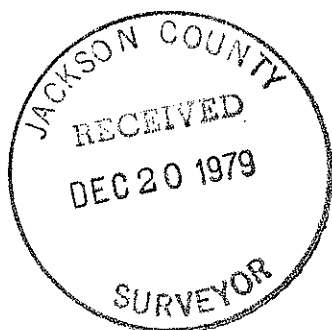

Verlyn Thomas
Professional Land Surveyor
304 South Holly
Medford, Ore. 97501
Phone 773-8866

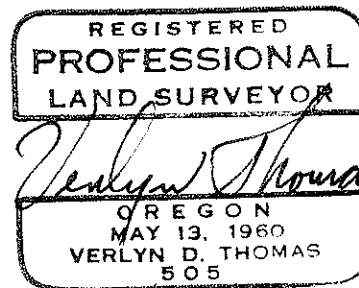

37-2W-20C
37-2W-19

37 2W 20C