

MAP OF SURVEY
 LOCATED IN
 SECTIONS 4, 9, & 10, T 36 S, R 2 E, W. M.
 JACKSON COUNTY, OREGON
 FOR
C2 CATTLE CO.

HOFFBUHR SURVEYING, INC. MEDFORD, OREGON



SCALE: 1" = 1000' DECEMBER 10, 1979
 BASIS OF BEARING R/S No. 6915

- --- SET 5/8" x 30" IRON REBAR WITH CAP MARKED "LS 1656"
- --- FD. JACKSON COUNTY BRASS CAP & BT'S
- ⊗ --- FD. BLM BRASS CAP & BT'S
- △ --- FD. 1 1/2" PIPE (see narrative)

REGISTERED
PROFESSIONAL
 LAND SURVEYOR

Roger R. Roberts

OREGON

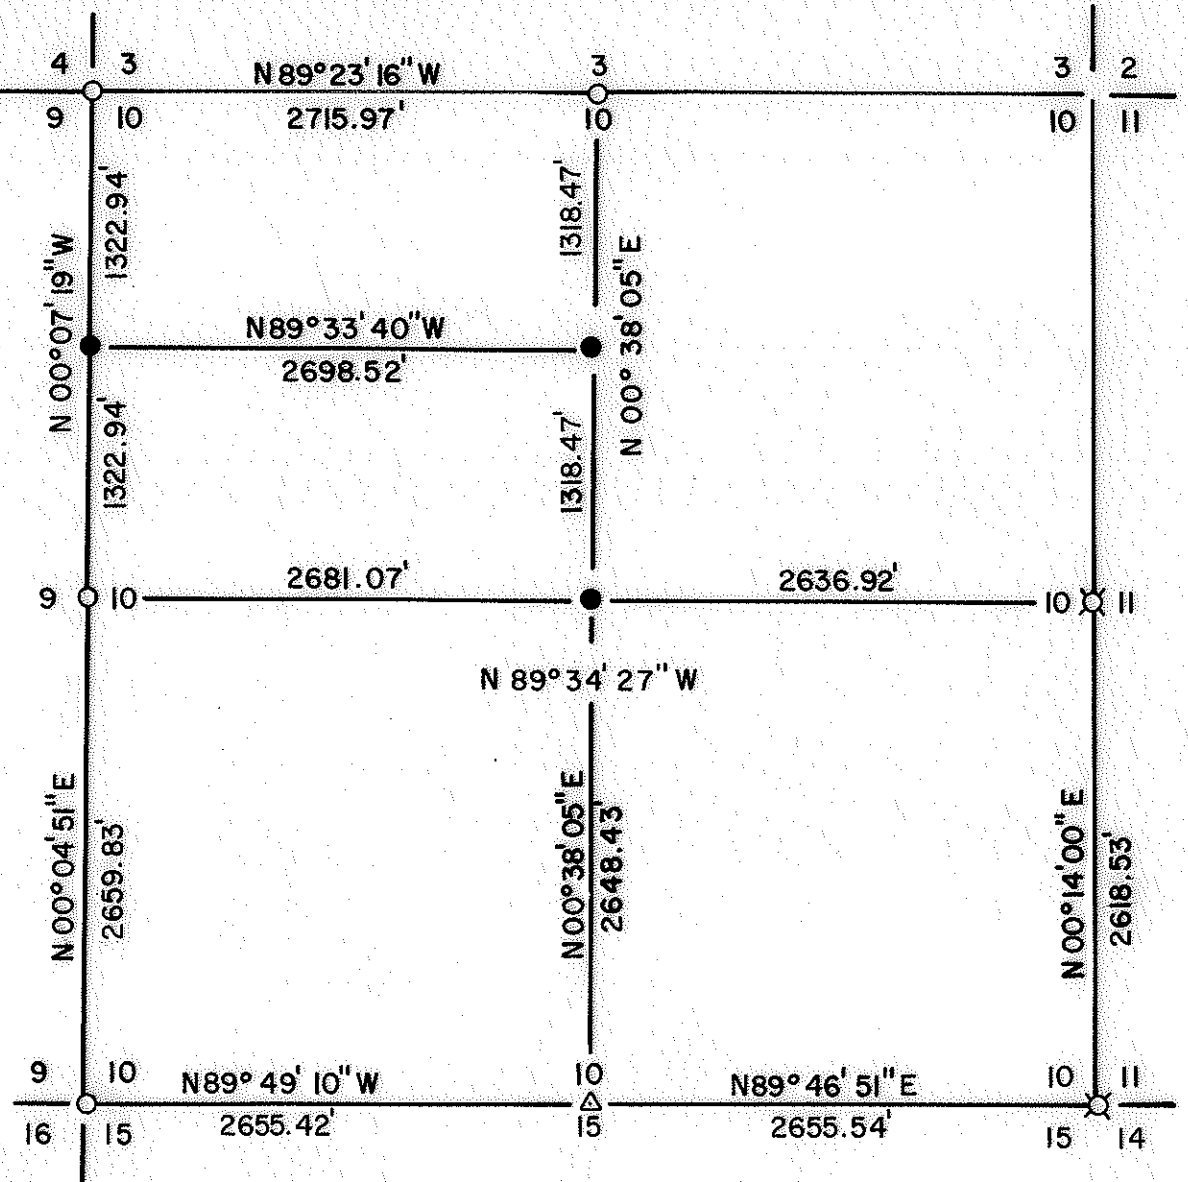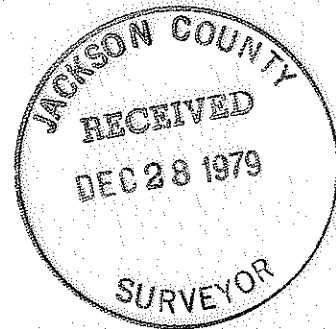

SURVEY NO. 8158

SURVEY NARRATIVE TO COMPLY WITH PARAGRAPH 209.250
OREGON REVISED STATUTES

SURVEY FOR: C2 Cattle Co.
Building 1, Suite 195
3000 Sand Hill Road
Menlo Park, California 94025

LOCATION: Sections 4, 9 and 10, in Township 36 South,
Range 2 East, Willamette Meridian, Jackson
County, Oregon

PURPOSE: To locate and mark property lines prior to
fenceline construction

PROCEDURE: All government corners found as shown on the attach-
ed map were tied together by random traverse, using a 1 second
theodolite and electronic distance meter. A search of the propor-
tionate location of the South one-quarter (1/4) corner of Section
10 yielded no additional evidence other than that described in a
"visit" report by the County Surveyor's Office. Therefore the 1-1/2
inch pipe, set by long time resident Vic Gardner, was accepted as
being the best evidence of the one-quarter (1/4) corner location.

The corners established on this survey are described as follows:

The one-quarter (1/4) corner common to Sections 4 and 9 consists
of a 5/8" x 30" rebar, exposed 7", from which
A 16" yew bears N 16° 30' E, 2.37 feet
A 7" yew bears S 71° W, 3.29 feet.

The center one-quarter (1/4) corner of Section 10 is marked
with a 5/8" x 30" rebar from which
A 10" white oak bears N 31° 32' W, 6.46 feet
A 9" fir bears N 87° 52' E, 35.75 feet.



The Center-North one-sixteenth (1/16) corner of Section 10 is
marked with a 5/8" x 30" rebar, exposed 3" in a mound of stone, from
which
An 8" fir bears N 23° 11' E, 23.96 feet
A 6" fir bears N 53° 15' E, 4.09 feet.

The North one-sixteenth (1/16) corner between Sections 9 and
10 is marked with a 5/8" x 30" rebar, exposed 6" in a mound of stone,
from which
A 7" white oak bears S 63° 26' E, 23.68 feet
A 7" white oak bears S 40° 04' W, 23.87 feet
The Northeast corner of a fenceline, nailed to a 9" white oak,
bears S 22° 50' E, 28.4 feet.


At the 1-1/2 inch pipe accepted for the South one-quarter (1/4)
corner of Section 10
A 7" white oak bears S 88° 11' W, 32.81 feet
An 11" white oak bears S 25° 49' E, 24.97 feet.

All bearing ties are to the center of the bearing tree at lower
blaze, and distances are to a nail and shiner at the center of the
tree at the root crown.

December 5, 1979

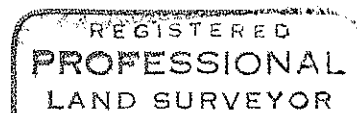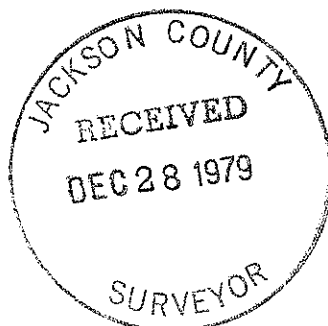

Roger R. Roberts

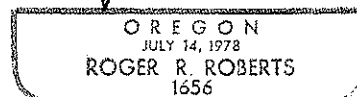

Roger R. Roberts
Hoffbuhr Surveying, Inc.

36 2E