

JACKSON COUNTY  
RECEIVED  
JAN 3 1980  
SURVEYOR

Fd 5/8" iron pin for  
the most Westlerly  
corner of R/S No. 7388

REGISTERED  
PROFESSIONAL  
LAND SURVEYOR

*Dennis N. Hoffbuhr*

OREGON  
JULY 14, 1979  
DENNIS N. HOFFBUHR  
1640

MAP OF SURVEY  
LOCATED IN  
BLOCK'S 2 & 7 of AMY & HARBAUGS ADDITION  
TO THE CITY of CENTRAL POINT, OREGON

FOR  
**THE MT. PITT COMPANY**

HOFFBUHR SURVEYING, INC. MEDFORD, OREGON  
BY: DENNIS N. HOFFBUHR PLS NO. 1640  
SCALE: 1" = 100' DECEMBER 27, 1979  
BASIS OF BEARING: R/S No. 7388

○ = SET 5/8" x 24" IRON PIN/ KAPS  
⊙ = FD. BRASS DISC. in CONCRETE

37 2W 104B

0 1 0 1

SURVEY NO. 8161

SURVEY NARRATIVE TO COMPLY WITH PARAGRAPH 209.250  
OREGON REVISED STATUTES

SURVEY FOR: The Mt Pitt Company  
P.O. Box 1309  
Medford, Oregon 97501



LOCATION: Blocks 2 & 7 of Amy & Harbaugh's Addition to the  
City of Central Point, Oregon, in the Northeast  
one-quarter (1/4), Section 10, Township 37 South,  
Range 2 West, Willamette Meridian, Jackson County,  
Oregon

PURPOSE: To survey and monument the parcel of land as shown  
on the attached map as per client's request

PROCEDURE: As shown on the attached map, located monuments  
for control to establish the centerline of streets, and located  
the centerline of the Southern Pacific mainline track to determine  
the bounds of the tract as shown.

Basis of bearing--Recorded Survey No. 7388

December 27, 1979

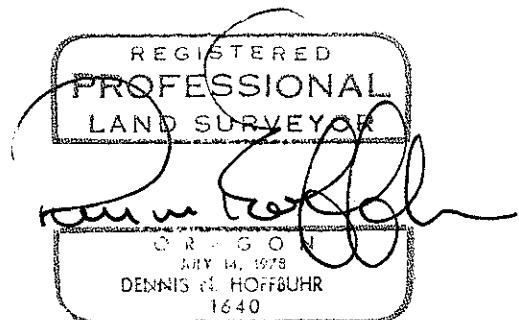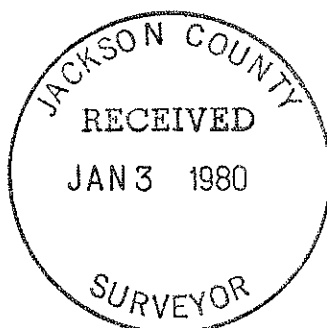

Dennis N. Hoffbuhr  
Hoffbuhr Surveying, Inc.