

FD. 2" IRON PIPE
 - N.E. COR. COUNTRY CLUB PARK



MAP OF SURVEY
 LOCATED IN
 N.E. 1/4 of Sec 29, T37 S, R1W, W.M.
 JACKSON COUNTY, OREGON
 FOR
JAMES HARPER
 HOFFBUHR SURVEYING, INC. MEDFORD, OREGON

SCALE. 1"=20' DECEMBER 22, 1979
 BASIS OF BEARING: R/S No. 1536

○= SET 5/8" x 24" IRON PINS WITH SUR KAPS
 ●= FD. 5/8" IRON PINS

SURVEY NO. 8166

SURVEY NARRATIVE TO COMPLY WITH PARAGRAPH 209.250
OREGON REVISED STATUTES

SURVEY FOR: James Harper
2520 Lyman Avenue
Medford, Oregon 97501



LOCATION: Northeast one-quarter (1/4) of Section 29,
Township 37 South, Range 1 West, Willamette
Meridian, Jackson County, Oregon

PURPOSE: To survey and monument a tract of land as described
in Instrument No. 75-01566 of the Official Records
of Jackson County, as per client's request

PROCEDURE: Using Recorded Survey No. 1536 as a basis for control
of this survey, set monuments as shown on the attached map.

Basis of bearing--Recorded Survey No. 1536

December 27, 1979

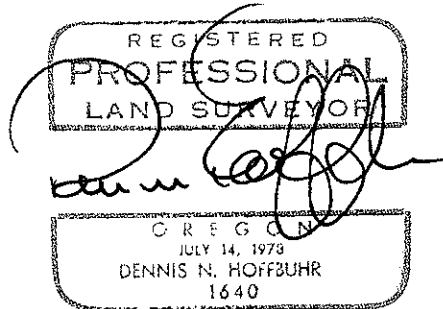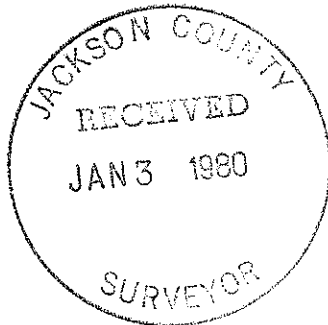

Dennis N. Hoffbuhr
Hoffbuhr Surveying, Inc.