


GRIZZLY INDUSTRIAL PARK SUBDIVISION

TO THE CITY OF ASHLAND

LOCATED IN D.L.C. NO. 42 IN SEC. 4 & 9, TWP. 39S., R.1E.W.M., JACKSON COUNTY, OREGON

POST MONUMENTATION MAP

- Monuments per original subdivision plat
- Monuments per original subdivision plat
- ◇ Set 5/8 x 24 inch Iron Pin tagged RLS 759
- ◆ Set 2 x 18 inch Iron Pipe with Bronze Cap in Monument Case

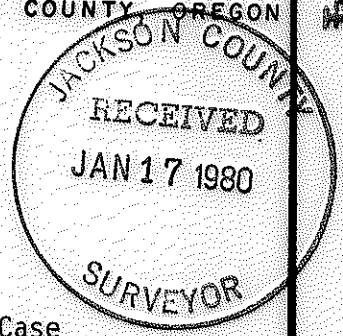

I, Everett L. Swain, duly Registered Surveyor of the State of Oregon, do hereby certify that this map represents a survey made by me or under my direction and the monuments conform to O.R.S. 92.060

Examined and approved this 9th day of January 1980

James H. Olson
City Surveyor

Filed for record this 17 day of January 1980 at 4:40 o'clock P M.

and recorded in the Official Records of Jackson County, Oregon.

Waldene Terry
County Clerk

Betty Kay
Deputy



REGISTERED
PROFESSIONAL
LAND SURVEYOR
Everett L. Swain
OREGON
JULY 8, 1966
EVERETT L. SWAIN
759

NOTE: See plat of GRIZZLY INDUSTRIAL PARK SUBDIVISION filed for record the 21st day of December, 1977 at 1:49 o'clock P.M. and recorded in Volume 13 of plats at page 21 of records of Jackson County, Oregon for lot bearings and distances.

8184

8184