


BASIS OF BEARINGS: R.S. 4184

SURVEY FOR: CARL PETERSON	
LOCATION: NW 1/4 SEC. 16, T. 35 S., R. 4 W. W. M. JACKSON COUNTY, OREGON.	
DATE: JAN. 24, 1980	<div style="border: 1px solid black; padding: 5px; text-align: center;"> REGISTERED PROFESSIONAL LAND SURVEYOR <i>Darrel W. Edwards</i> OREGON JULY 5, 1966 DARREL W. EDWARDS 741 </div>
SCALE: 1"=200'	
● MONUMENT FOUND	
○ 5/8" STEEL PIN SET	
() RECORD MEASUREMENT	

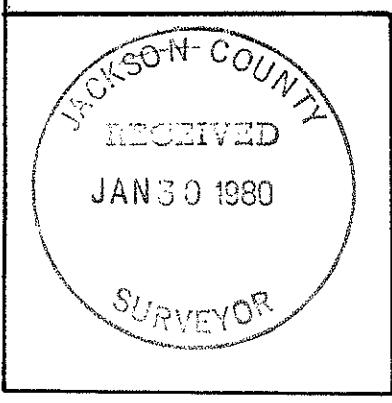

SURVEY NO. 8197

SURVEY NARRATIVE TO COMPLY WITH PARAGRAPH 209.250, OREGON REVISED STATUTES.

SURVEY FOR: Carl Peterson
4978 E. Evans Cr. Rd.
Rogue River, Or. 97537

LOCATION: In the NW 1/4 Section 16, Township 35 S., Range 4 W.W.M., in Jackson County, Oregon.

PURPOSE: To locate and monument property boundaries of one five acre tract and prepare legal description of same.

PROCEDURE: Found 5/8" steel pins set in R.S. No. 4184 on the South line of the North 1/2 of the Northwest Quarter of Section 16. Also found 5/8" steel right of way pins on the East line of West Evans Cr. Rd. Set 5/8" steel pins as shown on the accompanying plat.

BASIS OF BEARINGS: R.S. NO. 4184

DATE COMPLETED: January 24, 1980

Darrel W. Edwards
P.O. Box 801
Rogue River, Or. 97537

