


CERTIFIED RECORD OF LAND CORNER MONUMENTATION

History of original corner establishment: Fred Mensch, Sept. 24, 1913  
Set basalt stone 15"X12"X6", 10" in the ground for  
1/4 Section corner to Section 36 only, marked 1/4 on  
West face from which:

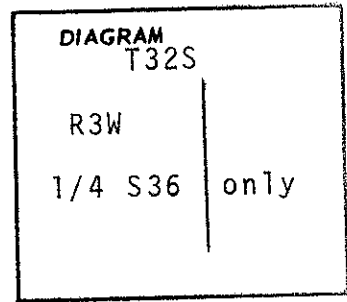

A Fir, 40" dia., bears S07°W., 40 Links dist.  
Marked 1/4 S36, BT.

A Fir, 36" dia., bears N48°W., 34 Links dist.  
Marked 1/4 S36, BT.

Description of corner evidence found: Found 15"X12"X6" stone set firmly 11" in the  
ground with 1/4 on West face & "X" on top, from which:

A Fir 48" dia., bears S06°50' W., 27.74 ft. dist., (42.03 Links)  
Blazed and healed.

A Fir, 40" dia., bears N48°50' W., 24.18 ft. dist., (36.64 Links)  
Blazed and healed.

Description of monument and accessories I established to perpetuate the  
original location of this corner

I set a 2 1/2"X30" aluminum  
pipe 24" in the ground at the location of the original rock, in a  
mound of stones, with a 2 1/2 aluminum cap marked:

T32S Wm  
R3W

No new BT's marked

I buried the original rock alongside the aluminum pipe,  
placed USFS BT Tags on the BT's and painted all blazes  
with red paint-6" band around each BT. I also placed a  
boundary and attention sign on a fiberglass fence post  
5' South of corner.

1/4  
S36  
RLS 601 1979

I hereby certify the above described corner  
monument was re-established as herein de-  
scribed on December 12, 1979.

*Michael J. Stanley*  
Michael J. Stanley  
Witness



Office of..... County of.....  
State of....., I hereby certify that the within instrument was filed in this office  
for record on the ..... day of.....  
..... by .....  
(COUNTY OFFICIAL) (DEPUTY)

