


8217

CERTIFIED RECORD OF LAND CORNER MONUMENTATION

History of original corner establishment: Charles L. Campbell, Contract No. 747, dated, May 5, 1902: Set ironstone 28"X12"X6", 21" in the ground for 1/4, marked 1/4 on W. face from which:

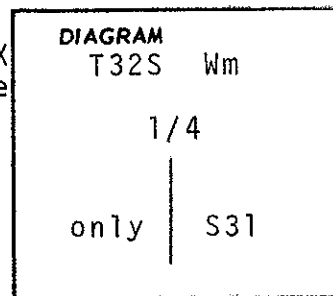

A Hemlock, 20" dia., bears N48 1/2° E., 12 Links dist. marked 1/4 S31, BT.

A Hemlock, 28" dia., bears S50 1/2° W., 61 Links dist. marked 1/4 S36 BT.

Fred Mensch, Sept. 24, 1913-Destroyed mark on W. face & mark 1/4 on E. face & destroyed marks on Hemlock in Section 36.

New BT marked:

A Yew, 16" dia., bears S80° E., 60 links dist., marked 1/4 S31 BT.

Description of corner evidence found: Found 28"X12"X6" stone, 14" in the ground on the east side of creek with 1/4 on East side, from which:

A Hemlock, 36" dia., brs., N52° 10' E., 6.60 ft. dist., (10 Links) Scribing visible.

A Yew, 20" dia., brs., S78° 15' E., 40.38 ft. dist., (61.2 Links) Scribing visible.

A Hemlock, 40" dia., brs., S46° 20' W., 35.46 ft., dist. (53.7 Links) Blazed-no scribing.

Description of monument and accessories established to perpetuate the original location of this corner

At the location of the original stone, I set a 2 1/2"X30" aluminum pipe 24" in the ground, in a mound of stones, with a 2 1/2" aluminum cap marked:

No new BT's marked.

T32S Wm

I buried the original stone alongside the pipe, placed USFS BT Tags on all three BTS, and painted all blazes and 6" bands on all trees with red paint. Placed boundary and attention sign 5' North of corner on a fiberglass fence post.

1/4 R2W

S31

RLS 601 1979

REGISTERED PROFESSIONAL LAND SURVEYOR

Malcolm N. Clark

OREGON JULY 12, 1963 MALCOLM N. CLARK 601

I hereby certify the above corner monument was re-established as herein described on December 11, 1979.

Michael J. Stanley

Michael J. Stanley
Witness

Office of County of
State of , I hereby certify that the within instrument was filed in this office
for record on the day of
..... by
(COUNTY OFFICIAL) (DEPUTY)

