

JACKSON COUNTY
RECEIVED
FEB 14 1980
SURVEYOR

REGISTERED
PROFESSIONAL
LAND SURVEYOR
OREGON
JULY 9, 1966
EVERETT L. SWAIN
759

MAP OF SURVEY
LOCATED IN
NE 1/4 OF SEC. 29, TWP. 40S., R. 2 E.W.M.
JACKSON COUNTY OREGON
FOR
JOSEPH H. ANGEL
SWAIN SURVEYING, INC.
ASHLAND, OREGON
JANUARY 31, 1980
RECORDED SURVEY NO. 5496
FOUND MONUMENT AS SHOWN Re: R.S. No. 5496
MONUMENT PER R.S. No. 5496
FOUND 5/8 INCH IRON PIN
SET 5/8x24 INCH IRON PIN TAGGED RLS 759

SURVEY NO. 8229

SURVEY NARRATIVE TO COMPLY WITH PARAGRAPH 209.250
OREGON REVISED STATUTES

SURVEY FOR: Joseph H. Angel
11100 Old Highway 99S
Ashland, Oregon 97520



LOCATION Situated in the Northeast quarter of Section 29, Township 40 South,
Range 2 East of the Willamette Base and Meridian, Jackson County,
Oregon.

PURPOSE: To survey, monument and prepare a legal description for the parcel
of land shown on the accompanying map.

PROCEDURE: From previous data established on Recorded Survey No. 5496 proceeded
to establish the boundary lines as shown on the accompanying
map.

January 31, 1980

Swain Surveying, Inc.
Ashland, Oregon

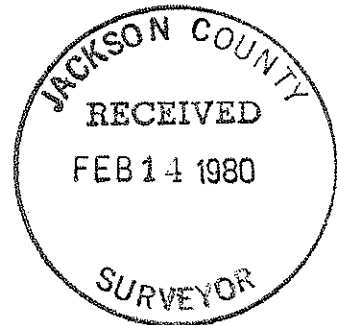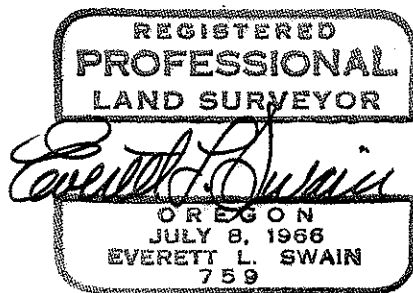

40 2 E 29