

LEGEND

- Found 3/4 inch Iron Pipe, unless otherwise shown, found and tied in October 1975
- Found 3/4 inch Iron Pipe, unless otherwise shown
- Set 5/8 x 24 inch Iron Pin tagged RLS 759

MAP OF SURVEY

located in
 Lot 9, Blk. 1 of Maple Subdivision in the City of Ashland
 in SE 1/4 of Sec. 5, Twp. 39S., R. 1 E.W.M.
 Jackson County Oregon

for


JOSEPH SAPIENZA

SWAIN SURVEYING, INC.

ASHLAND, OREGON

Scale: 1"=50'
 Basis of Bearing:

February 7, 1980
 N.O.A.A. True Bearing N-S Q Sec. 5

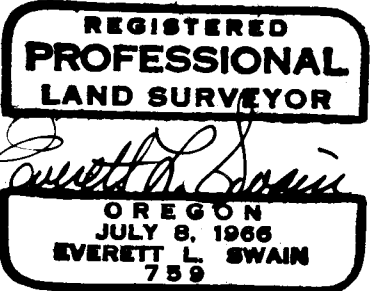

SURVEY NO. 8230

SURVEY NARRATIVE TO COMPLY WITH PARAGRAPH 209.250
OREGON REVISED STATUTES

SURVEY FOR: Joseph Sapienza
565 Maple Way
Ashland, Oregon 97520

LOCATION: Situated in Lot 9, Block 1 of Maple Subdivision in the City of
Ashland in the Southeast quarter of Section 5, Township 39 South,
Range 1 East of Willamette Base and Meridian, Jackson County,
Oregon.

PURPOSE: To survey and monument the North line of Lot 9, Block 1 of Maple
Subdivision in the City of Ashland, Oregon

PROCEDURE: From monuments found in October 1975 and additional monuments
tied, established the boundary line as shown on the accompanying
map.

February 7, 1980

Swain Surveying, Inc.
Ashland, Oregon

