

		SURVEY FOR: ADAMS & BUNN	
		SCALE: 1" = 100'	APPROVED BY:
		DATE: FEB. 20, 1980	DRAWN BY D.A.E.
LOCATION: NE 1/4 SEC. 3, T. 37 S., R. 1 W.M. IN JACKSON COUNTY, OREGON.		REVISOR	DRAWING NUMBER
● MONUMENT FOUND	--- FENCE LINE		
○ 5/8" STEEL PIN SET	() RECORD MEASUREMENT		

8251

SURVEY NO. 8251

SURVEY NARRATIVE TO COMPLY WITH PARAGRAPH 209.250, OREGON REVISED STATUTES.

SURVEY FOR: Adams and Bunn
2120 Oakwood Dr.
Medford, Or. 97501

LOCATION: In the NE 1/4 of Sec. 3, T. 37 S., R. 1 W.W.M., in Jackson County,
Oregon.



PURPOSE: To establish and monument property boundaries of parcels shown
on the attached map and prepare legal descriptions of same.

PROCEDURE: Found 5/8" steel pins on the East and South lines of subject
property. Also found the Northeast corner and the North 1/16
corner of Section 3 as per R.S. 1048. Set 5/8" steel pins as
shown on the accompanying plat.

BASIS OF BEARINGS: R.S. 1048

DATE COMPLETED: Feb. 20, 1980

Darrel W. Edwards
P.O. Box 801
Rogue River, Or. 97537
Ph: 582-3110

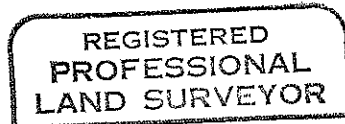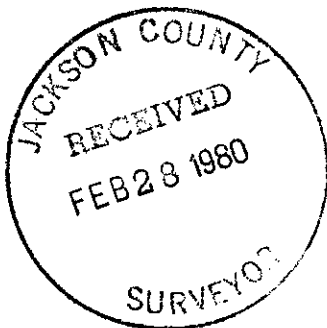

Darrel W. Edwards

