

FD. COUNTY SURVEYOR'S  
BRASS CAP MARKING THE  
1/4 SECTION CORNER

FD. 1/4 CORNER AS  
PER SURVEY NO. 7893

INST. NO.  
76-07601

SURVEY NO. 7205


PLAT OF SURVEY  
FOR  
**WILLIAM AND THOMAS PITTOCK**

BEING A PORTION OF THE N.1/2  
OF THE S.W. 1/4 OF SECTION 14  
TOWNSHIP 38 SOUTH, RANGE 4 WEST,  
WILLAMETTE MERIDIAN  
JACKSON CO. SCALE: 1"=100'  
OREGON DATE: FEB, 1980  
PREPARED BY: FRIAR-MOFFIT SURVEYING CO.

- LEGEND:**
- = FOUND MONUMENT AS SHOWN.
  - = FOUND 5/8" PIN WITH PLASTIC CAP STAMPED MOFFIT PLS 944.
  - ⊠ = FOUND 5/8" R/W PIN.
  - = SET 5/8" PIN WITH PLASTIC CAP STAMPED, MOFFIT PLS 944.

**BASIS OF BEARINGS:**  
SURVEY NO. 7205

REGISTERED  
PROFESSIONAL  
LAND SURVEYOR  
*Lloyd R. Moffit*  
OREGON  
JULY 17, 1969  
LOYD R. MOFFIT  
944

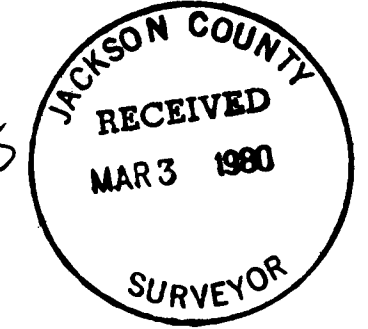

SURVEY NO. 8256

SURVEY NARRATIVE TO COMPLY WITH O.R.S. 209.250

SURVEY FOR: WILLIAM AND THOMAS PITTOCK  
1014 WEST 10TH  
MEDFORD, OR 97501

LOCATION: A PORTION OF THE NORTH ONE-HALF OF THE  
SOUTHWEST ONE-QUARTER OF SECTION 14,  
TOWNSHIP 38 SOUTH, RANGE 4 WEST, WILLAMETTE  
MERIDIAN, JACKSON COUNTY, OREGON.

PURPOSE: TO CORRECT AN ERROR MADE ON SURVEY NO. 8241.  
A MATHEMATICAL ERROR WAS MADE TYING THE  
WEST ONE-QUARTER OF SECTION 14. THIS  
CHANGED THE LOCATION OF THE PINS ON THE  
WESTERLY PORTION AND THE SOUTHERLY LINE  
OF THE TWO NEW PARCELS.

DATE: FEBRUARY 1980

FRIAR-MOFFIT SURVEYING CO.

