

8296


SURVEY FOR AUTOMATIC SALES CO.
S.W. 1/4 SEC. 31, T. 36 S., R. 1 W., W.M.
Jackson County, Oregon
March 26, 1980

REGISTERED
PROFESSIONAL
LAND SURVEYOR

Verlyn Thomas

OREGON
MAY 13, 1900
VERLYN D. THOMAS
P.L.S.

JACKSON COUNTY
RECEIVED
MAR 28 1980
SURVEYOR

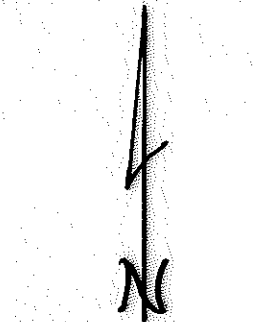

SCALE: 1" = 100'

LEGEND

- Mon. Found (5/8" I. Pin)
- 5/8" X 24" I. Pin Set

BASIS OF BEARINGS: Survey No. 2050

PEACE
LANE

SEE SURVEY
NO. 2378

N 89° 53' 40" W 249.0 0.163

438.38

439.12 (Rec. 439.04)

N 0° 10' 20" W

249.0

N 89° 43' 30" W 1875.12 (Rec. 1874.75)

29.68

31 | 32

6 | 5

B. CAP

36 | 31

1 | 6

B. CAP

30

VILAS

ROAD

SURVEY NO. 8296

SURVEY NARRATIVE TO COMPLY WITH ORS 209.250

FOR: Automatic Sales Co.
P.O. Box 1137
Coos Bay, Oregon

PURPOSE: To monument parcel according to description furnished by client.

PROCEDURE: Established section line and centerline of Vilas Road between section corners as shown on accompanying plat. Recovered additional monuments as indicated on Recorded Survey No. 2378, and established additional corner monuments as shown on accompanying plat.

BASIS OF BEARINGS: Survey No. 2050

