

8297


SURVEY FOR LEE KNAUSS
N.W. 1/4 SEC. 28, T.36S., R.2W., W.M.
JACKSON COUNTY, OREGON
August 23, 1979



Scale: 1" = 200"


LEGEND

- Mon. Found
 - 5/8" X 24" I. Pin Set
- BASIS OF BEARINGS: Survey No. 3312

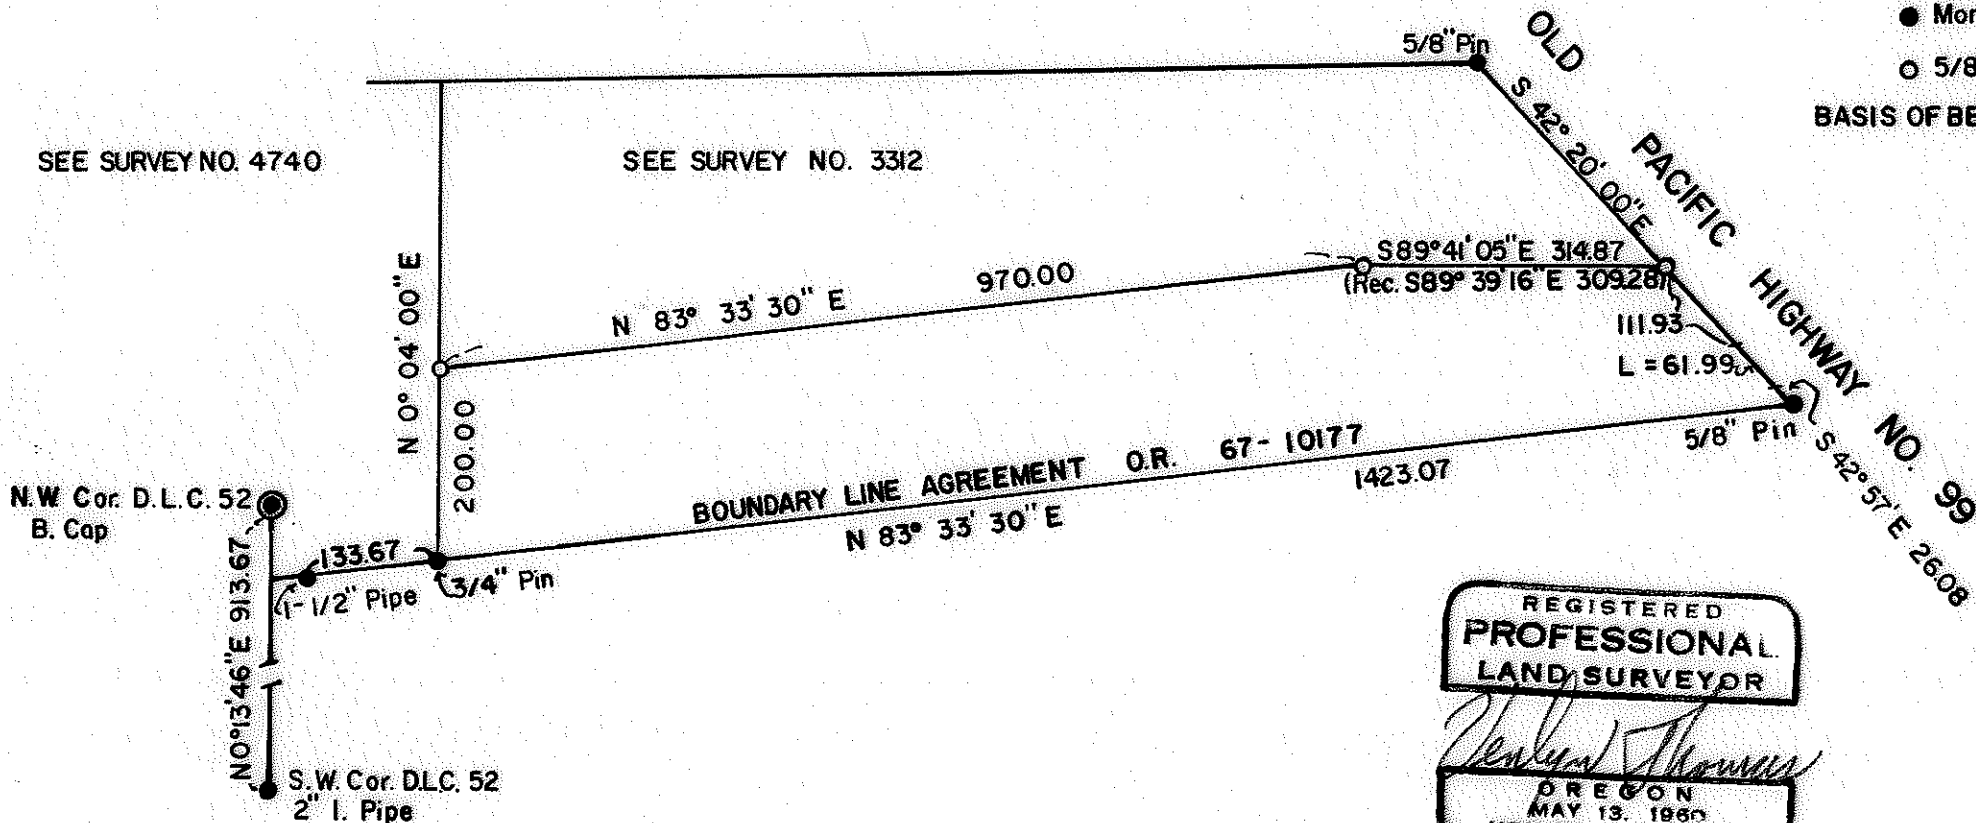

REGISTERED
PROFESSIONAL
LAND SURVEYOR

Verlyn Thomas
OREGON
MAY 13, 1960
VERLYN D. THOMAS
507

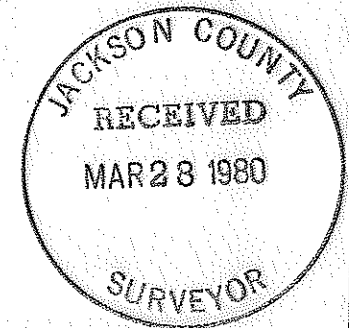

SURVEY NO. 8297

SURVEY NARRATIVE TO COMPLY WITH O.R.S. 209.250

FOR: Lee Knauss
6807 Blackwell Road
Central Point, Oregon

PURPOSE: To survey and monument a division line according to legal description furnished by client.

PROCEDURE: Recovered monuments previously established in performing Recorded Survey No. 3312, and monuments indicated by Survey No. 4740.
Monumented division line as shown on accompanying plat.

BASIS OF BEARINGS: Survey No. 3312

