

Survey for:

# JACKSON COUNTY PARKS AND RECREATION DEPT.

Located in  
DLC No. 43 in the  
E. 1/2 of Sec. 15,  
T. 38 S. R. 1 W, W.M.

BY: BOYDEN SURVEYORS  
APRIL 7, 1980

RECORDED SURVEY NO. 1891

NW Corner  
DLC No. 43

SE Corner  
DLC No. 42

Highway Mon. A (see Recorded Survey no. 5011)  
(Sta. 1084+75.54)

N89°56'20"E

662.40'

Wit. Cor.

Found 5/8" iron pin 0.11'S and 0.07'E from prop. corner

150'

Sta. 1095+00

INTERSTATE HIGHWAY NO. 5

S42°03'20"E

Sta. 1098+00

Wit. Cor.

N58°23'10"W  
960.75'

WESTERLY BOUNDARY VOLUME 52, PAGE 549 D.R.

STATE OF OREGON

1003.46'



SCALE: 1"=100'  
BASIS OF BEARING:  
Recorded Survey No.  
5011  
With azimuth decreased by  
 $\theta = 1^{\circ}34'30''$   
● Set 3/4" X 24" Rebar

REGISTERED PROFESSIONAL  
LAND SURVEYOR  
*Sandy D. Kauer*

JACKSON COUNTY  
RECEIVED  
APR 7 1980  
SURVEYOR

N64°50'15"W  
247.56'

R=339.63'  
L=157.66'

R=339.63'  
L=62.96'

S77°56'40"W  
78.74'

150'

38 1W 15D

8313

SURVEY NARRATIVE TO COMPLY WITH O.R.S. 209.250

FOR: Jackson County Parks and Recreation Dept.  
80 East Stewart Avenue  
Medford, Oregon

BY: Boyden Surveyors  
26 Laurel Street  
Medford, Oregon

PURPOSE: To monument as one tract a combined tract made up of the parcels described in Inst. Nos. 77-11833 and 77-12834 O.R. being located in Section 15, T38SR1W, W.M.



PROCEDURE: From E.D.M. ties to control monuments set on or incorporated in Recorded Survey No. 5011, the North boundary of D.L.C. No. 43 was calculated between the NW corner of said Claim and the SE corner of D.L.C. No. 42.

The Southwesterly right-of-way of Interstate Highway No. 5 was also calculated from said E.D.M. ties (said calculated right-of-way line agreed with a found 5/8" iron pin located at Sta. 1095+00).

The Southerly boundary of the subject tract was monumented as shown on the annexed map.

Basis of bearings is Recorded Survey No. 5011 with azimuth decreased by  $\theta = 1^{\circ}34'30''$ .

April 7, 1980

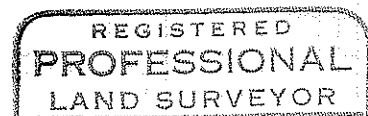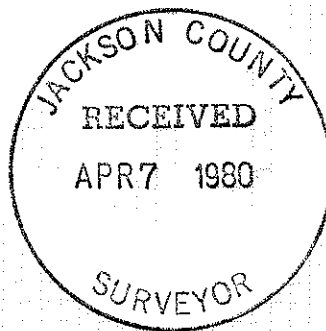

*Gary D. Kaiser*

