

MAP OF SURVEY  
 LOCATED IN  
 NE. 1/4 SECTION 3, T 37S, R 1W, W.M.  
 JACKSON COUNTY, OREGON  
 FOR  
**JOHN DYER**  
 HOFFBUHR SURVEYING, INC.  
 MEDFORD, OREGON  
 BY: RICHARD L BATH PLS No. 1069  
 SCALE: 1" = 100' MARCH 10, 1980  
 BASIS OF BEARING: R/S No. 8202

- ⊙ = Set 5/8" x 24" IRON PIN  
tagged "R.BATH LS. 1069"
- ⚡ = Fd. 5/8" IRON PIN  
per R/S No. 677
- = Fd. 5/8" IRON PIN  
per R/S No. 4713

REGISTERED  
**PROFESSIONAL**  
 LAND SURVEYOR  
*Richard L. Bath*  
 OREGON  
 JULY 30, 1976  
 RICHARD L. BATH  
 No. 1069

SURVEY NO. 8335

SURVEY NARRATIVE TO COMPLY WITH PARAGRAPH 209.250  
OREGON REVISED STATUTES

SURVEY FOR: John Dyer  
4155 Dry Creek Road  
Medford, Oregon 97501



LOCATION: Northeast one-quarter (1/4), Section 3,  
Township 37 South, Range 1 West, Willamette  
Meridian, Jackson County, Oregon

PURPOSE: To survey, monument and describe the parcel  
as shown on attached map per client's request

PROCEDURE: Utilizing control established by this office for  
Recorded Survey No. 8202 and control per Recorded Survey No. 677,  
the South and West lines of a new parcel were monumented as shown  
on attached map. Monuments found per Recorded Survey No. 677  
checked with their record position, but monuments set per Recorded  
Survey No. 4713 were ignored because of inconsistencies with  
previous control per Recorded Survey No. 8202.

Basis of Bearing--Recorded Survey No. 8202

April 9, 1980

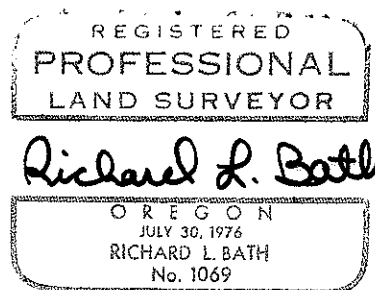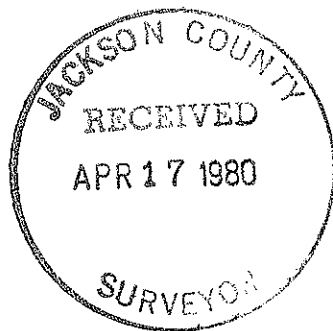

Richard L. Bath  
Hoffbuhr Surveying, Inc.  
219 North Oakdale  
Medford, Oregon 97501