
SEC. 30 SW 1/16

MAP OF SURVEY

LOCATED IN THE SW I/4 OF SECTION 30, T.37S., R.2W, W.M., JACKSON COUNTY, OREGON.

FOR

T.FLATEBO AND K.C.WEAVER

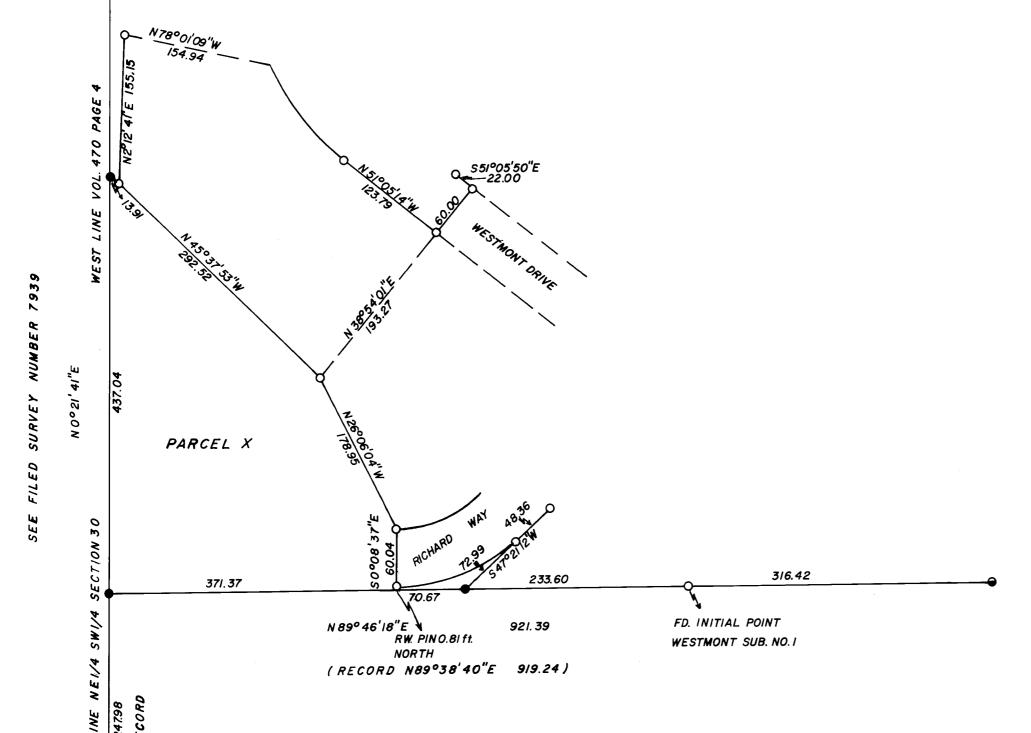

BASIS OF BEARING. SURVEY NO. 7939

- O FD. 5/8" IRON PINS
- FD.1/2" IRON PINS
- SET 5/8"x 30" IRON PINS SCALE I"= 100'

DATE: MARCH 7, 1980





SURVEY NARRATIVE TO COMPLY WITH O.R.S. 209.250.

Survey for: T. Flatebo and K.C. Weaver

P.O. BOX 900

Jacksonville, Oregon 97530

Location: Located in the Southwest quarter of Section 30,

Township 37 South, Range 2 West, Willamette

Meridian, Jackson County, Oregon.

Purpose: To monument and tie existing momuments at the

corners of Parcel "X" as shown on the

accompanying map.

Procedure:

Utilizing control from filed survey number 7939, performed by this office, I tied found monuments on Westmont Heights Subdivision and filed surveys number 3454 and 4202. The SW 1/16 corner of Section 30 was set after a thorough search of the area for the 1" pipe shown on Survey #3454. The Section subdivision can be reviewed on Survey #7939. The recovered monuments from survey #4202 together with those on Westmont Heights Sub were held for the North and East boundaries of Parcel "X". A strip of land exists between that parcel surveyed on survey #4202 and the West line of the NE 1/4 of the SW 1/4 of Section 30. Apparently this was the intent as evidenced by the survey # 4202.

The SW corner of Parcel "X" was established at record distance from the SW 1/16 corner and the line from there through the I.P. of Westmont Heights Sub to the found 1/2 inch iron pin shown on survey #3454 and called for in the description of the adjoining tract to the South was held for the South line.

Surveyed By:

T. Flatebo and Associates, Inc.

P.O. Box 900

Jacksonville, Oregon 97530

Date:

March 7, 1980

856151

PROFESSIONAL



APR 1 7 1980