
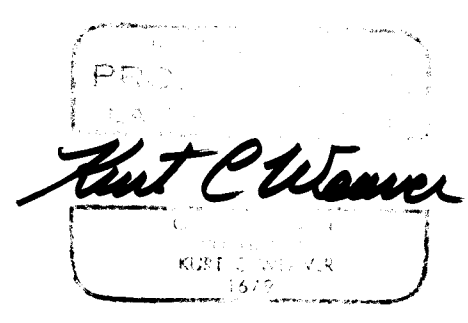


PROPOSED EASEMENT & COURSES

- (1) N 06°07'46"E 179.63
- (2) N 01°10'54"E 123.69
- (3) N 13°08'55"E 116.83
- (4) N 45°14'00"E 169.40
- (5) N 33°02'35"E 176.43
- (6) N 38°40'54"E 121.35
- (7) N 33°02'08"E 188.95
- (8) N 25°06'37"E 207.41
- (9) N 39°02'26"E 229.45
- (10) N 36°44'20"E 157.63
- (11) N 00°40'16"E 134.59
- (12) N 48°22'53"E 207.87
- (13) N 49°15'22"E 278.35
- (14) N 58°23'35"E 133.88
- (15) N 46°50'50"E 123.03
- (16) N 38°24'10"E 189.25
- (17) N 39°59'09"E 139.04
- (18) N 26°12'48"E 193.52

MAP OF SURVEY
 LOCATED IN SECTION 8, T. 41S., R. 2E., W.M.,
 JACKSON COUNTY, OREGON.
 FOR
MR. COLLIS P. MAHAN

BASIS OF BEARING: SOLAR OBSERVATION
 ● FD. JACKSON COUNTY BRASS CAP
 SCALE: 1" = 400 FT.
 DATE: FEBRUARY 29, 1980

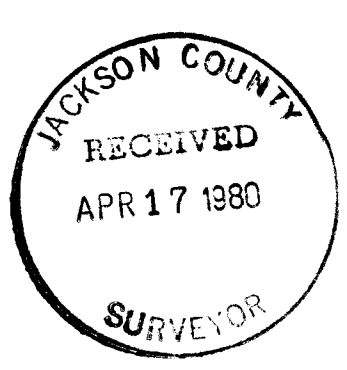

FD. G.L.O. Pipe and B.C.
 W. OAK 10" dia. bears N 11°29'E 18.7
 (rec. N 14°E 18.5)
 W. OAK 18" dia. bears S 45°46'E 40.9
 (rec. S 45°E 41.6)
 W. OAK 8" dia. bears S 22°49'W 40.0
 (rec. S 22°W 39.6)

FD. G.L.O. Pipe and B.C.
 TREES NOT TIED

D.L.C. 37
 (REC. NORTH 132)

D.L.C. 38
 (REC. N 1°15' W 797.94)



SURVEY NARRATIVE TO COMPLY WITH O.R.S. 209.250

Survey For: Mr. Collis P. Mahan
P.O. Box 485
Fortuna, California 95540

Location: Located in Section 8, Township 41 South,
Range 2 East, Willamette Meridian,
Jackson County, Oregon.

Purpose: To subdivide Section 8 in order to control
the survey of a proposed easement across
B.L.M. land, and to set the center 1/4
corner which controls property boundaries
within said Section 8.

Procedure: All controlling corners were tied via a
series of closed traverses, utilizing a
wild T-1 theodolite and a H.P. 3805 A E.D.M.
The East 1/4 corner of Section 8 was not
found after extensive search, both prior to
and after establishment of the proportionate
position. The County Surveyor's office also
searched for the corner.

Bearing was based on a solar observation.

Surveyed By: T. Flatebo and Associates, Inc.
P.O. Box 900
Jacksonville, Oregon 97530

Date: February 29, 1980

REGISTERED
PROFESSIONAL
LAND SURVEYOR
Kurt C. Weaver
OREGON
JULY 14, 1978
KURT C. WEAVER
1679

JACKSON COUNTY
RECEIVED
APR 17 1980
SURVEYOR