

JACKSON COUNTY  
RECEIVED  
APR 30 1980  
SURVEYOR

|   |  |                |
|---|--|----------------|
| REGISTERED<br>PROFESSIONAL<br>LAND SURVEYOR<br><br><i>Darrel W. Edwards</i><br>OREGON<br>JULY 8, 1959<br>DARREL W. EDWARDS<br>741 | SURVEY FOR: FRANK VAUGHN AND ED WAGNER   |                |
|   | SCALE: 1" = 500'<br>DATE: 4-2-80         | APPROVED BY:   |
| LOCATION: SEC. 4, T. 36 S., R. 4 W.W.M., JACKSON COUNTY, OREGON.  |  |                |
| —X—X—X— FENCE LINE<br>( ) RECORD MEASUREMENT  | ● MONUMENT FOUND<br>○ 5/8" STEEL PIN SET | DRAWING NUMBER |

SURVEY NO. 8350

SURVEY NARRATIVE TO COMPLY WITH PARAGRAPH 209.250, OREGON REVISED STATUTES.

SURVEY FOR: Ed Wagner and Frank Vaughn  
2500 Sykes Cr. Road  
Rogue River, Or. 97537

LOCATION: Section 4, T. 36 S., R. 4 W.W.M., in Jackson County, Oregon.


PURPOSE: To locate and monument property boundaries of the three parcels shown on the attached map. Also, to determine area amounts of land encroached upon by fencing.

PROCEDURE: Found Brass Caps at the East and West 1/4 corners, the Southwest corner and the Southeast corner of Section 4. Also found a 1 1/2" iron pipe at the South 1/4 corner and a 1" iron pipe at the North 1/4 corner. Traversed to these monuments and subdivided the Section as shown. Set 5/8" steel pins as shown on the accompanying plat.

BASIS OF BEARINGS: R.S. 6379 ( County survey of East Evans Cr. Rd.).

DATE COMPLETED: April 2, 1980.

Darrel W. Edwards  
P.O. Box 801  
Rogue River, Or. 97537  
Ph: 582-3110

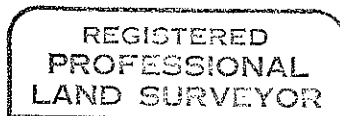

*Darrel W. Edwards*

