

MAP OF SURVEY  
FOR  
ROGUE RIVER NATIONAL FOREST  
P.O. BOX 520  
MEDFORD, OREGON  
APRIL 23, 1980

RS NO 7306



BASIS OF BEARING = R.S. 7306 (SOLAR OBSERVATION)

SCALE IN FEET  
0 500 1000

SCALE IN METERS  
0 100 200 400


1 METER = 3.280833 FEET

HISTORY OF SURVEYS

THE SURVEY OF THE WEST LINE OF SECTION 30 WAS PERFORMED BY TURNER AND HOWARD UNDER CONTRACT NO. 142, DATED SEPTEMBER 9, 1870. A RESURVEY OF THIS LINE WAS PERFORMED BY PETER APPLIGATE UNDER CONTRACT NO. 651, DATED APRIL 25, 1896.

THE SURVEY OF THE NORTH, EAST AND SOUTH LINES WAS PERFORMED BY RUFUS S. MOORE UNDER CONTRACT NO. 496, DATED MARCH 3, 1884. A DEPENDENT RESURVEY OF THE NORTH LINE WAS PERFORMED BY THE BUREAU OF LAND MANAGEMENT IN 1962.

ALL CONTROLLING SECTION CORNERS HAD BEEN REMONUMENTED BY THE BUREAU OF LAND MANAGEMENT AND JACKSON COUNTY SURVEYOR WITH THE EXCEPTION OF THE ONE-QUARTER CORNER, SECTION 25 ONLY, TOWNSHIP 32 SOUTH, RANGE 2 EAST, WHICH WAS REMONUMENTED BY R.L.S. NO. 759 AND THE ONE-QUARTER CORNER COMMON TO SECTION 36, TOWNSHIP 32 SOUTH, RANGE 2 EAST AND SECTION 31, TOWNSHIP 32 SOUTH, RANGE 3 EAST, WHICH WAS REMONUMENTED BY R.E. NO. 7122.


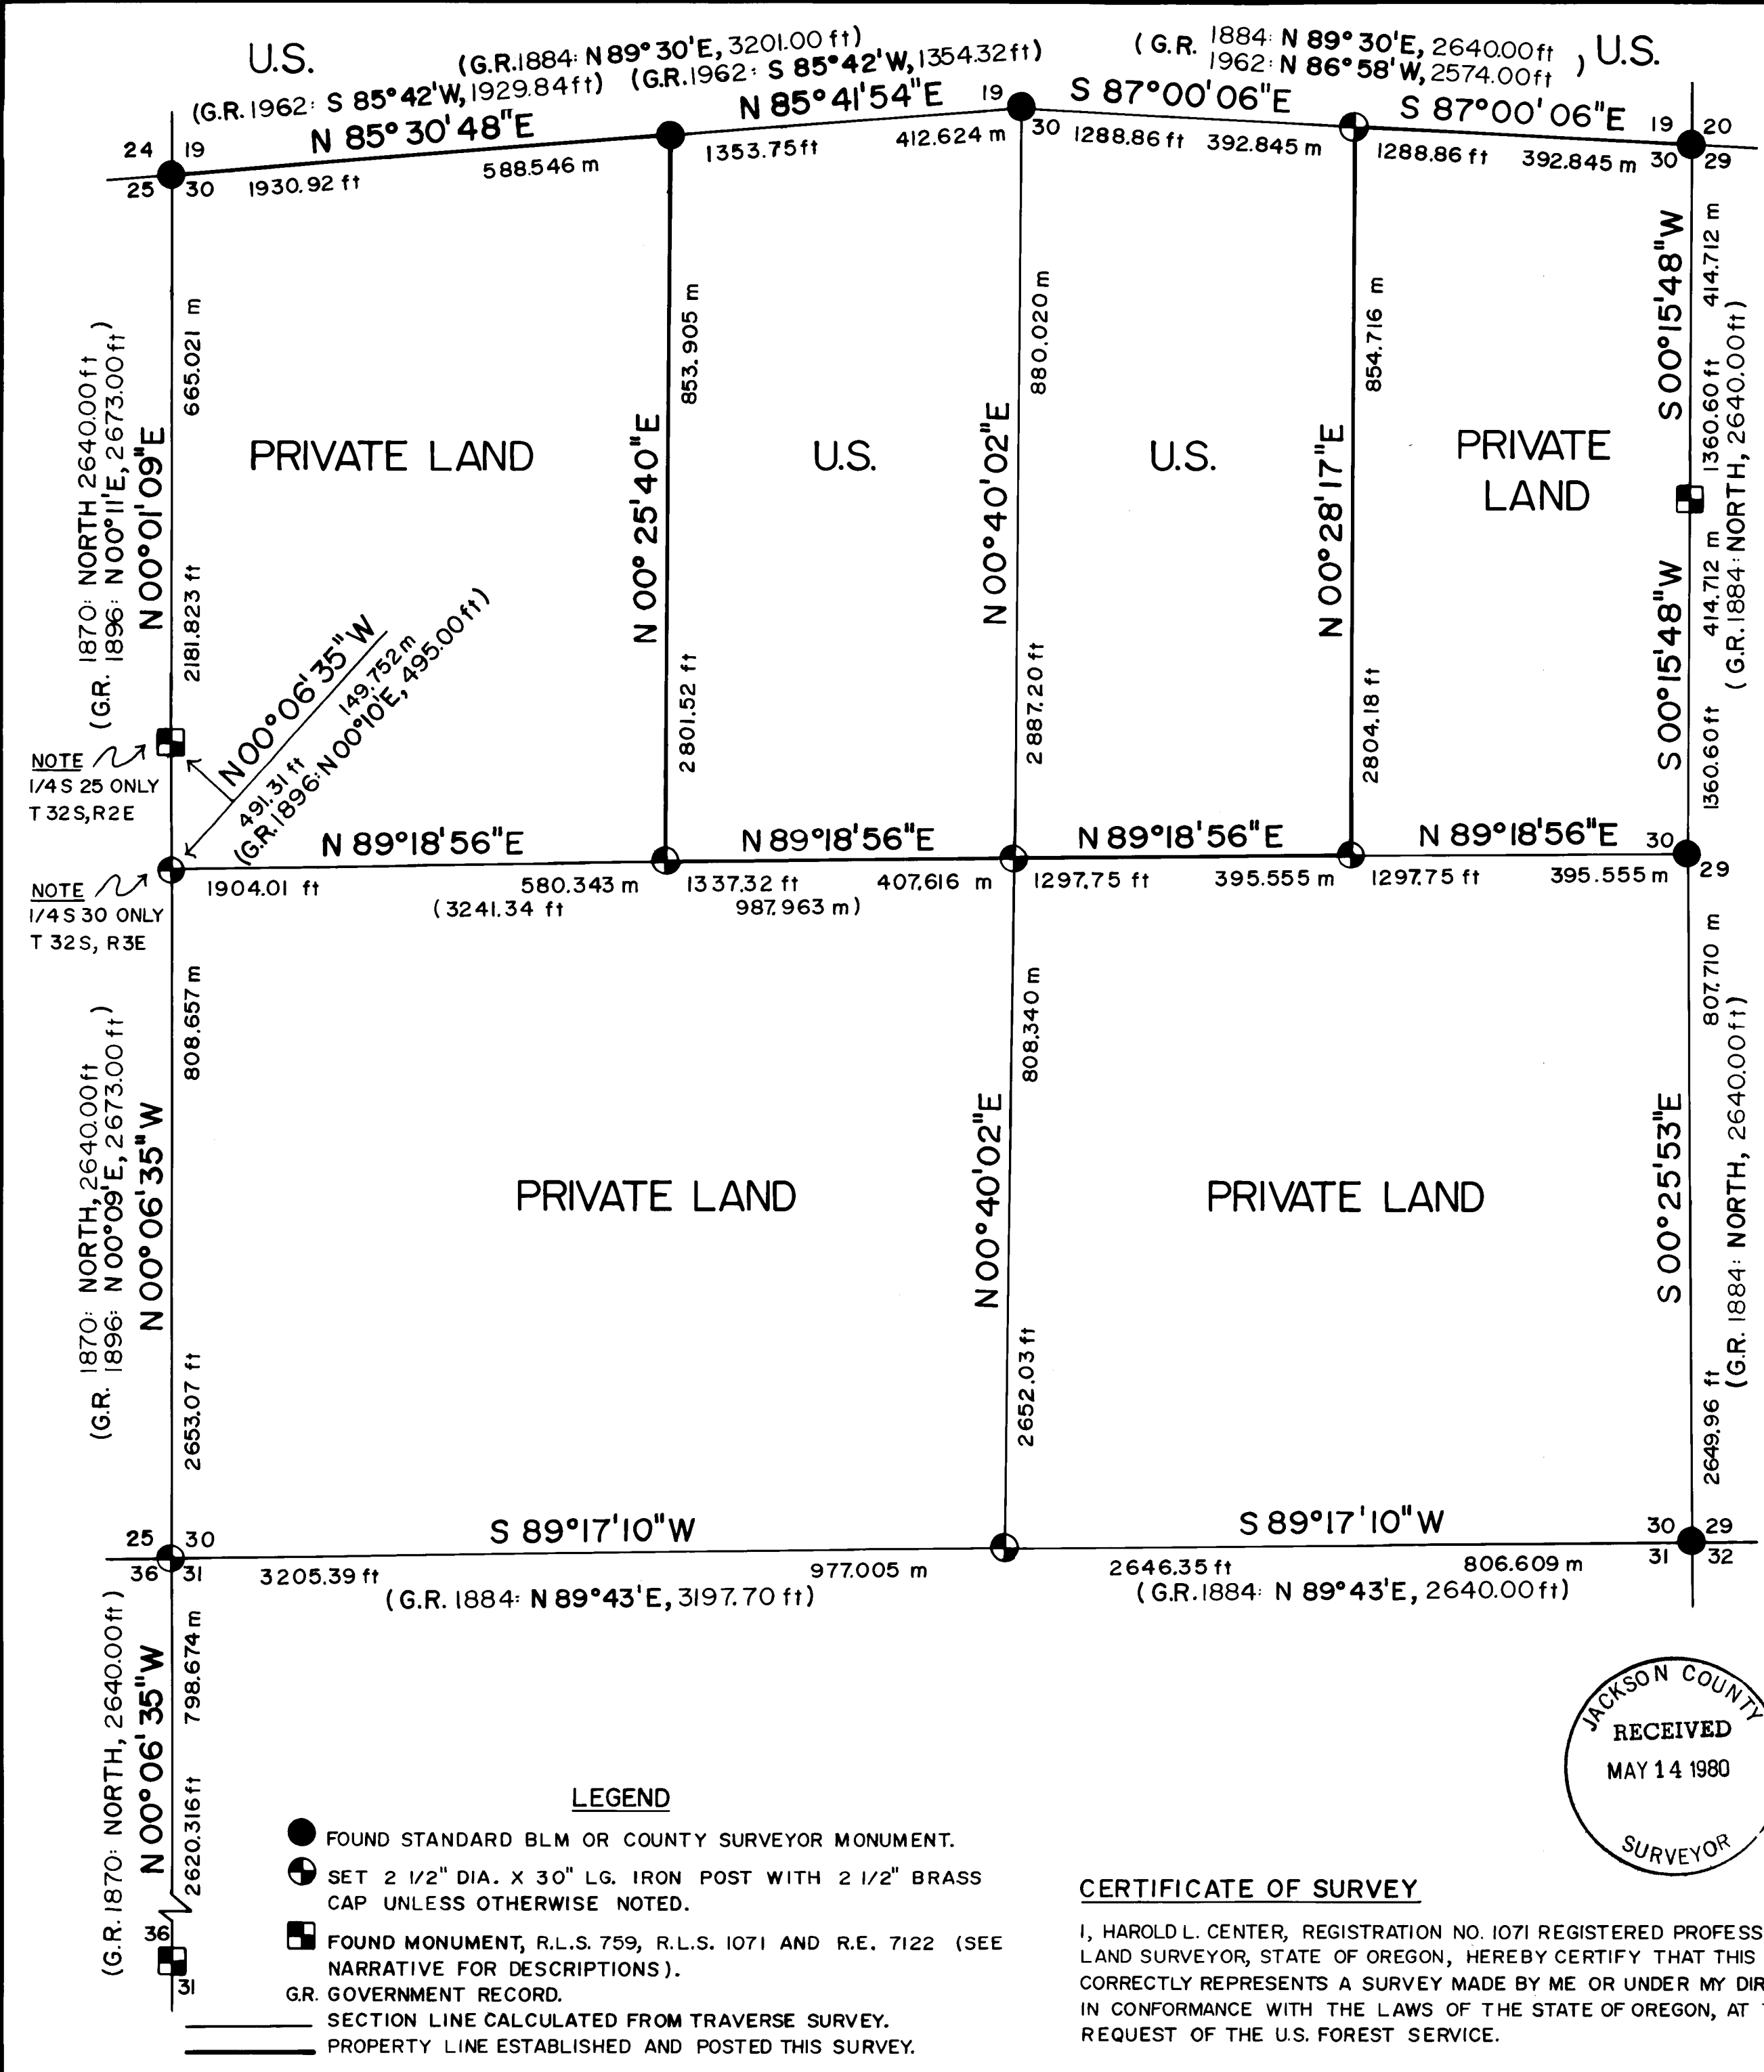


LEGEND

- FOUND STANDARD BLM OR COUNTY SURVEYOR MONUMENT.
- ⊕ SET 2 1/2" DIA. X 30" LG. IRON POST WITH 2 1/2" BRASS CAP UNLESS OTHERWISE NOTED.
- ⊞ FOUND MONUMENT, R.L.S. 759, R.L.S. 1071 AND R.E. 7122 (SEE NARRATIVE FOR DESCRIPTIONS).
- G.R. GOVERNMENT RECORD.
- SECTION LINE CALCULATED FROM TRAVERSE SURVEY.
- PROPERTY LINE ESTABLISHED AND POSTED THIS SURVEY.

CERTIFICATE OF SURVEY

I, HAROLD L. CENTER, REGISTRATION NO. 1071 REGISTERED PROFESSIONAL LAND SURVEYOR, STATE OF OREGON, HEREBY CERTIFY THAT THIS MAP CORRECTLY REPRESENTS A SURVEY MADE BY ME OR UNDER MY DIRECTION IN CONFORMANCE WITH THE LAWS OF THE STATE OF OREGON, AT THE REQUEST OF THE U.S. FOREST SERVICE.

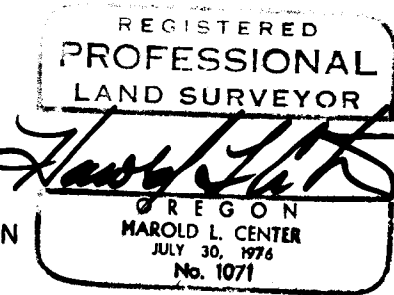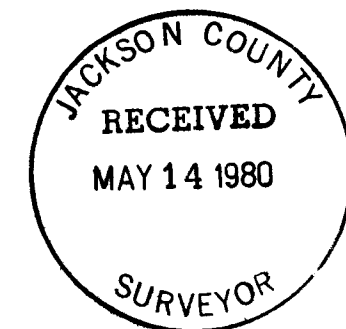

U.S. DEPARTMENT OF AGRICULTURE <b>FOREST SERVICE</b>	
REGION 6	ROGUE RIVER NAT. FOREST
DEPENDENT RESURVEY and SECTION SUBDIVISION SEC. 30 T. 32 S., R. 3 E., W.M. JACKSON COUNTY, OREGON	
REVIEWED BY <i>[Signature]</i>	DATE 5/7/80
REVIEWED BY <i>[Signature]</i>	DATE 5-8-80

91-09960

8364 <sup>500</sup>/<sub>600</sub>

AFFIDAVIT OF CORRECTION  
pursuant to ORS 209.255

1:49


I, Harold L. Center, Registered Professional Land Surveyor in the State of Oregon, Certificate No. 1071 do hereby state that I have discovered errors and omissions on that survey filed as Record Survey No. 8364 on April 23, 1980 with the Jackson County Surveyor. The corrections are as follows:

The Center-east one-sixteenth corner for Section 30, Township 32 South, Range 3 East, Willamette Meridian, Jackson County, Oregon. An error was found in the corner move, resulting in the corner to be set N.71°48'41"W., 1.84 feet out of the true position as indicated on the map of survey.

At the corner position as indicated on the Map of Survey, I reset the same 2 1/2" diameter, 30" long iron post 10" below the road surface, from which the following original accessories:

A 16" diameter fir bears N.53°21'W., 34.9 feet distance, with a healed blaze.

A 24" diameter fir bears N.78°34'E., 30.1 feet distance, with a healed blaze.

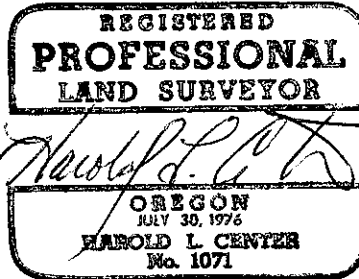


STATE OF OREGON )  
County of Jackson )

May A.D., 1991.

Personally appeared the above named Harold L. Center, a Registered Professional Land Surveyor, and acknowledged the foregoing instrument to be his voluntary act and deed.

Before Me:

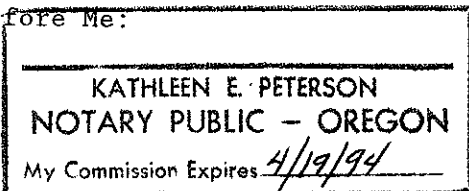

*Kathleen E. Peterson*  
Notary Public for the State of Oregon  
My commission expires 4/19, 1994.

I, Verlyn Thomas, Jackson County Surveyor, hereby certify that I have examined this Affidavit of Correction, and that the changes are permitted in accordance with the Oregon Revised Statutes 209.255.

*Verlyn Thomas*  
Verlyn Thomas, Jackson County Surveyor

Jackson County, Oregon  
Recorded  
OFFICIAL RECORDS

1:49 MAY 7 1991 P.M.

KATHLEEN S. BECKETT  
CLERK and RECORDER  
*Glenda Bartlett* Deputy

From which the following references: AFFIDAVIT OF CORRECTION  
 O.R. 91-09960.

16 21 34.90 V. THOMAS, C.S. 5/16/91


A ~~14~~-inch diameter fir bears N 53° ~~22'~~ W ~~32.40~~ feet distance. Scribed  
 CE 1/16 S30 LS 1071 BT.

24 76° 34' 30.1

A ~~20~~-inch diameter fir bears N ~~77° 23'~~ E ~~31.50~~ feet distance. Scribed  
 CE 1/16 S30 LS 1071 BT.

Center one-quarter corner Section 30, Township 32 South, Range 3 East.

At the corner point I set a 2 1/2-inch diameter galvanized iron post with a 2 1/2-inch diameter brass cap marked:

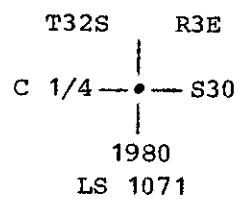


From which the following references:

- A 16-inch diameter fir bears N 04° 30' W 44.80 feet distance. Scribed C 1/4 S30 LS 1071 BT.
- A 9-inch diameter fir bears S 67° 49' E 34.50 feet distance. Scribed C 1/4 S30 LS 1071 BT.

Center west one-sixteenth corner Section 30, Township 32 South, Range 3 East.

At the corner point I set a 2 1/2-inch diameter galvanized iron post with a 2 1/2-inch diameter brass cap marked:

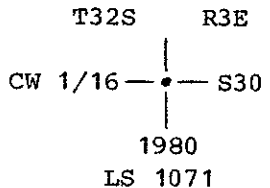



From which the following references:

- A 9-inch diameter fir bears N 59° 32' E 29.42 feet distance. Scribed CW 1/16 S30 LS 1071 BT.
- A 9-inch diameter yew bears S 02° 51' E 8.75 feet distance. Scribed CW 1/16 S30 LS 1071 BT.

This survey performed utilizing a Wild T-2 Theodolite and Hewlett-Packard 3805 Electronic Distance Meter.

April 23, 1980

HAROLD L. CENTER  
 Registered Professional Land Surveyor  
 Oregon Certificate No. 1071

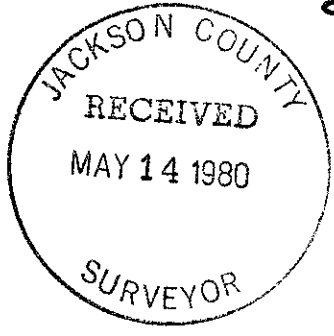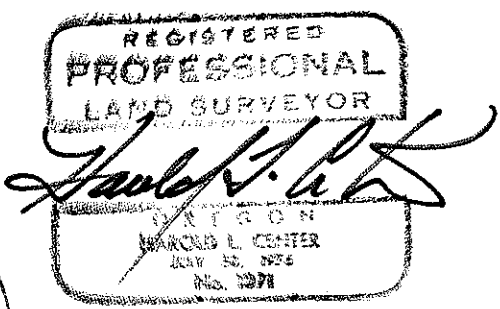

From which the following references:

A 10-inch diameter fir bears N 12° 43' E 13.50 feet distance. Scribed 1/4 S30 LS 1071 BT.

A 11-inch diameter fir bears S 79° 11' W 10.50 feet distance. Scribed 1/4 S31 LS 1071 BT.

One-quarter corner common to Section 30, Township 32 South, Range 3 East.

At the corner point I set a 2½-inch diameter galvanized iron post with a 2½-inch diameter brass cap marked:

T32S    R3E  
 |  
 R2E • ¼ S30  
 |  
 1980  
 LS 1071

From which the following references:

A 10-inch diameter fir bears N 22° 41' E 42.96 feet distance. Scribed 1/4 S30 LS 1071 BT.

A 11-inch diameter cedar bears S 41° 01' E 33.60 feet distance. Scribed 1/4 S30 LS 1071 BT.

East one-sixteenth corner common to Sections 19 and 30, Township 32 South, Range 3 East.

At the corner point I set a 2½-inch diameter galvanized iron post with a 2½-inch diameter brass cap marked:

T32S    R3E  
 |  
 E 1/16    S19  
           S30  
 |  
 1980  
 LS 1071

From which the following references:

A 8-inch diameter fir bears S 46° 52' W 36.20 feet distance. Scribed E 1/16 S30 LS 1071 BT.

A 12-inch diameter fir bears N 87° 22' W 18.00 feet distance. Scribed E 1/16 S19 LS 1071 BT.

Center east one-sixteenth corner Section 30, Township 32 South, Range 3 East.

At the corner point I set a 2½-inch diameter galvanized iron post with a 2½-inch diameter brass cap marked:

T32S    R3E  
 |  
 CE 1/16 — • — S30  
 |  
 1980  
 LS 1071

Monument falls within the road bed of Forest Service Road No. 318 and was set 1.10 feet distance below road surface.

At the corner point I found a standard BLM monument marked:

U. S. Dept of Interior  
 Unlawful to disturb  
 T32S R3E  
 1/4  $\frac{S19}{S30}$   
 1962  
 Cadastral Surveys  
 Bureau of Land Management

From which the following references:

A 23-inch diameter cedar bears N 13° 12' E 65.00 feet distance. Scribe 1/4 S 19 visible.

A 12-inch diameter fir bears S 27° 47' W 47.10 feet distance. Healed blaze.

A 30-inch diameter fir stump bears S 54° 54' W 9.20 feet distance. Face has been chopped out and is badly decayed.

A 27-inch diameter pine stump bears N 13° 17' W 50.20 feet distance. Face has been chopped out and is badly decayed.

CORNERS ESTABLISHED THIS SURVEY

Secton corner common to Sections 30 and 31, Township 32 South, Range 3 East, and Sections 25 and 36, Township 32 South, Range 2 East.

At the corner point I set a 2½-inch diameter galvanized iron post with a 2½-inch diameter brass cap marked:

T32S  
 R2E R3E  
 25 | 30  
 —•—  
 36 | 31  
 1980  
 LS 1071

From which the following references:

A 13-inch diameter fir bears S 35° 15' W 89.50 feet distance. Scribed T32S R2E S36 LS 1071 BT.

A 15-inch diameter fir bears N 48° 52' W 54.40 feet distance. Scribed T32S R2E S25 LS 1071 BT.

A 9-inch diameter cedar bears N 62° 09' E 50.48 feet distance. Scribed T32S R3E S30 LS 1071 BT.

A 9-inch diameter fir bears S 78° 19' E 81.25 feet distance. Scribed T32S R3E S31 LS 1071 BT.

One-quarter corner common to Sections 30 and 31, Township 32 South, Range 3 East.

At the corner point I set a 2½-inch diameter galvanized iron post with a 2½-inch diameter brass cap marked:

T32S R3E  
 1/4  $\frac{S30}{S31}$   
 1980  
 LS 1071

A 12-inch diameter yew bears S 55° 15' W 22.80 feet distance. Scribe 1/4 S visible.

A 30-inch diameter fir bears N 85° 45' E 13.60 feet distance. Healed blaze.

Section corner common to Sections 19 and 30, Township 32 South, Range 3 East, and Section 25, Township 32 South, Range 2 East.

At the corner point I found a standard BLM monument marked:

U. S. Dept. of Interior  
Unlawful to disturb  
T32S  
S25 | S19  
     | S30  
1962  
Cadastral Surveys  
Bureau of Land Management

From which the following references:

A 15-inch diameter fir bears S 27° 57' W 7.75 feet distance. Healed blaze.

A 12-inch diameter fir bears N 73° 32' E 52.50 feet distance. Healed blaze.

A 18-inch diameter fir bears S 26° 08' E 7.80 feet distance. Tree broken and decayed, scribe E S 30 visible.

A 14-inch diameter fir bears S 20° 21' E 41.82 feet distance. Healed blaze.

West one-sixteenth corner common to Sections 19 and 30, Township 32 South, Range 3 East.

At the corner point I found a standard BLM monument marked:

U. S. Dept of Interior  
Unlawful to disturb  
T32S R3E  
W 1/16 | S19  
         | S30  
1962  
Cadastral Surveys  
Bureau of Land Management

From which the following references:

A 15-inch diameter fir bears N 36° 22' E 15.50 feet distance. Healed blaze.

A 13-inch diameter fir bears S 07° 16' E 44.33 distance. Healed blaze.

One-quarter corner common to Sections 19 and 30, Township 32 South, Range 3 East.

From which the following references:

A 7-inch diameter fir bears N 42° 24' E 69.00 feet distance. Scribe CS-BT visible.

A 19-inch diameter cedar bears S 62° 58' E 5350 feet distance. Scribe CS-BT visible.

A 14-inch diameter fir bears S 38° 04' W 18.75 feet distance. Healed blaze-tree now dead.


A 10-inch diameter fir bears S 54° 16' W 17.60 feet distance. Scribe CS-BT visible.

One-quarter corner common to Section 31, Township 32 South, Range 3 East, and Section 36, Township 32 South, Range 2 East.

At the corner point I found a 14-inch diameter cedar fence post as described by R. A. Morris, Registered Professional Engineer, within Record Survey No. 4717.

From which the following references:

A 1-inch diameter galvanized iron post with 1½-inch diameter bell pipe reducer filled flush with pot metal attached bears north 0.90 feet distance marked:

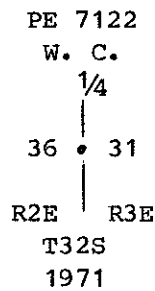


A 14-inch diameter fir bears N 55° 00' W 36.70 feet distance. Healed Blaze.

A 9-inch diameter fir bears N 45° 00' E 18.30 feet distance. Healed blaze.

One-quarter corner common to Section 25, Township 32 South, Range 2 East.

At the corner point I found a 1-inch diameter galvanized iron post monument with 2-inch diameter brass cap, established by E. L. Swain, Registered Land Surveyor No. 759, as described within Record Survey No. 5797-H, monument marked:

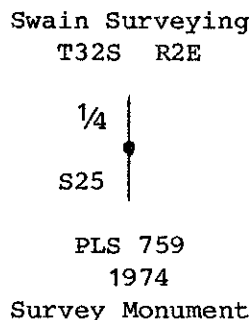

From which the following references:

A 10-inch diameter hemlock bears S 28° 19' W 38.34 feet distance. Scribe 1/4 S 25 PLS 759 BT visible.

SURVEY NARRATIVE TO COMPLY WITH  
PARAGRAPH 209.250 OREGON REVISED STATUTES

SURVEY FOR: Rogue River National Forest  
P. O. Box 520  
Medford, Oregon 97501

LOCATION: Section 30, Township 32 South, Range 3 East, Willamette  
Meridian, Jackson County, Oregon.

BASIS OF BEARING: Record Survey No. 7306  
(Solar observation)

PURPOSE: To establish property corners and mark and post mutual  
property lines separating National Forest and private  
lands.

PROCEDURE: Prior to commencement of this survey an investigation of  
controlling corners was made. Corners along the west  
line of Section 30 had been recovered during my survey  
of Section 29 and were held as controlling corners for  
this survey. My investigation also recovered the north  
one-quarter corner, the northwest and southeast corners  
of Section 30, the one-quarter corner Section 25,  
Township 32 South, Range 2 East, and the one-quarter  
corner common to Section 31, Township 32 South, Range 3  
East, and Section 36, Township 32 South, Range 2 East.

With the above corner control verified I began a series  
of closed traverses from control established during my  
survey of Section 29 and proceeded to tie the above  
corner control. From this data corner positions were  
computed and search areas determined. Extensive search  
for lost corners was performed, with assistance provided  
by deputies from the Jackson County Surveyors office  
without positive success. The area where the missing  
corners are situated has been the subject of extensive  
logging on at least 2 separate occasions allowing for  
limited success in corner evidence recovery. I,  
therefore, establish lost corners by proportionate  
measurement and mark lines as shown on the attached map  
of survey.

Corners Accepted for Control

Note - The section corner common to Sections 19, 20, 29 and 30, north one-  
sixteenth corner common to Sections 29 and 30, and the one-quarter corner  
common to Sections 29 and 30, Township 32 South, Range 3 East, were  
described within Record Survey No. 7306 and were found as described within  
that survey and will not be redescribed within this narrative.

Section corner common to Sections 29, 30, 31 and 32, Township 32 South,  
Range 3 East.

At the corner point I found a standard Jackson County Surveyors brass cap  
monument marked:

Jackson County  
T32S R3E  
30	29
31 | 32  
1979