

SURVEY FOR: L. & R. PROPERTIES


LOCATED IN D.L.C. NO. 44 AND THE S.E. 1/4 OF SECTION 30, T.37S., R.1W., W.M.

BY: BOYDEN SURVEYORS
MAY 19, 1980

REGISTERED
PROFESSIONAL
LAND SURVEYOR

Gary D. Kaiser

OREGON
JULY 16, 1987
GARY D. KAISER
No. 803

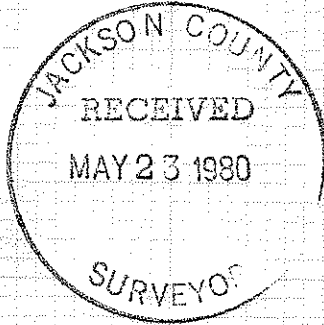

VOL. 268, P.627, D.R.

Found 3/4" re-bar

N67°49'E 93.45'

N22°11'W 105.0'

S22°11'E 52.0'

20,000 SQ. FT. ±

FILED SURVEY NO. 6890

SCALE: 1" = 50'

BASIS OF BEARINGS:
FILED SURVEY NO. 4019

SANITARY SEWER MAIN

S589°59'40"W

S213°46'S 180.96'

S227°55'S 227.855'

SOUTHBOUND OFF-RAMP
N36°35'35"W

Found 3/4" re-bar

70.79'

549.75'

S589°59'40"W 620.54'

S47°29'40"W 29.75'

1" iron pipe

North 11.25'

West 351.03'

FILED SURVEY NO. 4019

N.W. CORNER
D.L.C. No. 50

- Set 5/8" x 24" re-bar with plastic cap marked "KAISER RLS 803."

8379

371W 30D 8379

Survey No. 8379

SURVEY NARRATIVE TO COMPLY WITH O.R.S. 209.250

SURVEY FOR: L. & R. Properties
328 South Central Avenue
Medford, Oregon

SURVEY BY: Boyden Surveyors
26 Laurel Street
Medford, Oregon

PURPOSE: To monument and describe a tract located in the
SE 1/4 of Section 30, T37SR1W, W.M. in Medford,
Oregon.

PROCEDURE: From control monuments previously set or utilized
on Filed Survey Nos. 4019 and 6890, the desired
tract was monumented as shown on the annexed map.
Basis of bearings is Filed Survey No. 6890.

May 19, 1980

