



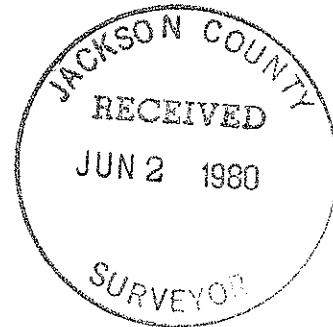

The subdivision of the section was computed and the interior corners set as shown on the accompanying map. The 5/8 pin set on the North line of the Government Lot 2 was set for the Northeast corner of that parcel owned by Mr. Bill Granish.

Surveyed By: T. Flatebo and Associates, Inc.  
P.O. Box 900  
Jacksonville, Oregon 97530  
Phone 899-8267

Date: May 9, 1980

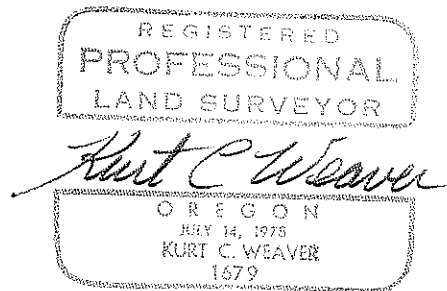

## SURVEY NARRATIVE TO COMPLY WITH O.R.S. 209.250.

Survey for: Mr. John Henderson  
P.O. Box 3517  
Central Point, Oregon 97502

Location: Located in Northwest quarter and the Southwest quarter of Section 18, Township 39 South, Range 2 West of the Willamette Meridian, Jackson County, Oregon.

Purpose: To subdivide Section 18 in order to monument those 1/16 corner positions and the Center 1/4 as shown on the accompanying map.

Procedure: I initially tied the existing center 1/4 corner monument as shown on filed survey number 6951. This survey was performed by Mr. C.H. Ketchum in 1977. It was discovered that the C 1/4 corner did not fit the dimensions called for to the West 1/4 corner, nor did the bearing and distance from the West 1/4 corner to the Southwest corner of Section 18 fit with that represented on the map. It became apparent that Mr. Ketchum's position of the West 1/4 corner was in error. This condition results in the invalidation of all of the interior corners represented on said survey. The West 1/4 corner position was also control for the proportion position of the lost Northwest corner of Section 18.

Having determined that the previous subdivision of Section 18 was wrong I tied the controlling corners as shown on the accompanying map. These controlling corners were encompassed in a series of closed traverses. The Northwest corner of Section 18 was looked for extensively after the proportion position had been determined. No evidence of the original corner or accessories could be located. The corner position lies on a West-Southwest exposure and has been severely burned over and is covered with dense brush. The ridge call to the North of the proportion position fits fairly well. An old blaze on a P.Pine on this ridge also lies close to line. This tree also has a "Crater National Forest" tag on it. I consulted with Harold Center and Tom Newcomb of the U.S.F.S. regarding any information about this corner which used to be on the Forest Boundary. They directed me to a map at the office of the County Surveyor showing corners that had been visited in the old Crater National Forest. They also informed me that the records of these corner visitations had been destroyed several years ago. The above mentioned map was located and it showed that the corner had been visited in 1929. This information did not offer much assistance in the recovery of the corner position, however, it did enable us to concentrate our search to a more confined area, ie; relative to the tagged pine. We also made search for more Forest Boundary tags. The corner was not recovered so I set a monument at the proportionate position.