


S. 1/4 COR. SEC. 28



BASIS OF BEARINGS: RS 3058

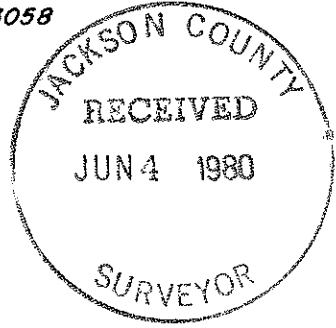

PREPARED FOR: CHARLES BOWKER	
LOCATION: SW 1/4 SEC. 28, T. 35 S., R. 3 W. W. M., JACKSON COUNTY, OREGON	
DATE: MAY 5, 1980	REGISTERED PROFESSIONAL LAND SURVEYOR <i>Darrel W. Edwards</i> OREGON JULY 8, 1968 DARREL W. EDWARDS 741
SCALE: 1" = 100'	
MONUMENTS FOUND	
5/8" STEEL PINS SET	
() RECORD MEASUREMENTS	

SURVEY NUMBER 8391

SURVEY NARRATIVE TO COMPLY WITH PARAGRAPH 209.250, OREGON REVISED STATUTES.

SURVEY FOR: Charles Bowker
436 1/2 Sardine Cr. Rd.
Gold Hill, Or. 97525

LOCATION: SW 1/4 Sec. 28, T. 35 S., R. 3 W.W.M., in Jackson County, Oregon,

PURPOSE: To locate and monument property boundaries of parcels shown on the attached map and described in Deed Records.

PROCEDURE: Found monuments set in R.S. 3058. Finding these to be very accurate, I used them for a base and set 5/8" steel pins as shown on the accompanying plat.

BASES OF BEARINGS: R.S. 3058

DATE COMPLETED: May 5, 1980

Darrel W. Edwards
P.O. Box 801
Rogue River, Or. 97537
Ph: 582-3110

