

Note:
 The bearing of East used for North Line of Sec. 2 and D.L.C. 37 this survey equals a true bearing by Solar obser'tn of $S89^{\circ}21'45''E$

D.R. 347-360

D.L.C. 37
 T. 39S, R. 1W, W.M.


Harry & David Inc.
 D.R. 341-493-501
 Parcel #9

R 6476



East 231.00'
 Pt. of Beg. (D.R. 37-419)
 (798.60' South and 1195.92' East of Cor. Sec. 2, 3, 34 and 35)
 Wagner School
 DR 37-419
 West 165.00'

Boundary Survey of Property
 situate in
 D.L.C. 37 T. 39S, R. 1W, W.M.
 Jackson County Oregon
 L.P. Lovejoy, L.S. Medford, Ore.
 Scale 1"=100'
 Dec. 10, 1953
 Rev. Sept 15, 1955

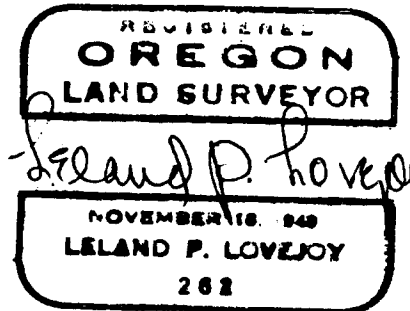

Survey Narrative To Comply With Section 87-330

State of Oregon Law 1947


Survey For: Don Kerby
Talent, Oregon

Purpose of Survey: Run out property boundaries

Survey Location: D. L. C. 37, Township 39 South, Range 1
West, Willamette Meridian, Jackson
County, Oregon

Survey Procedure: Found monuments and corners as shown
on map. Set 3/4" galvanized iron pipe at
property corners.

Leland P. Lovejoy
Registered Land Surveyor
Work completed September 20, 1955

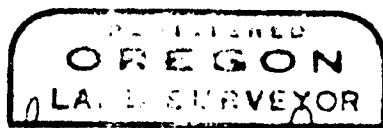

Leland P. Lovejoy

