

JACKSON COUNTY
RECEIVED
JUL 3 1980
SURVEYOR

REGISTERED
PROFESSIONAL
LAND SURVEYOR
Edward A. McGinty
OREGON
JULY 10, 1953
EDWARD A. MCGINTY
301

SURVEY IN NE. 1/4 SEC. 36, T. 37S., R. 2W. WM.

For: A. J. BEATON
80-13

BY: EDWARD A. MCGINTY
MEDFORD, OREGON
JUNE 1980

SCALE 1" = 100'
© FD. Conc. & B. Disc.
o = Set 5/8" x 24" I. Pin

8421

SURVEY NO. _____

SURVEY NARRATIVE TO COMPLY WITH O.R.S. 209-250

AMENDMENT TO SURVEY NO. 8421.


Survey for : Mr. A. J. Beaton 80-13
1304 Kings Hwy
Medford, Or 97501

Survey by : Edward A. McGinty, R.S.
P.O. Box 1531
Medford, Or
June, 1980

Basis of Bearing: Survey No. 1193

Location: DLC 84, in NE 1/4 of Sec. 36, T37S, R2W, WM
Jackson County, Oregon

A drafting error was made on the Westerly line on distance
should be 138.33 instead of 138.83.

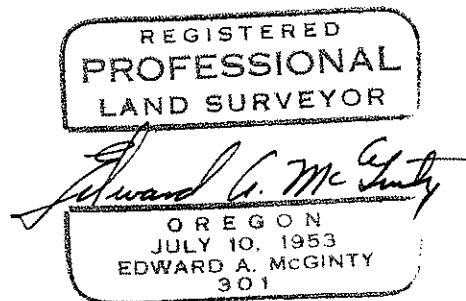

8421

SURVEY NARRATIVE

SURVEY NARRATIVE TO COMPLY WITH O.R.S. 209-250

Survey for: Mr. A. J. Beaton 80-13
1304 Kings Hwy.
Medford, Or 97501

Survey by: Edward A. McGinty, R.S.
P.O. Box 1531
Medford, Or 97501
June, 1980

Basis of Bearing: Survey No. 1193

Location: DLC 84, in NE 1/4 of Sec. 36, T37S, R2W, WM.
Jackson Co., Oregon

Precedence of Survey:

Surveyed tract as shown, the Northerly line was determined by running parallel to Stewart Ave. and 550 ft. southerly. This survey agrees closely to the actual occupation, except on the Westerly line, which appears to be an irrigation easement or is being used for irrigation, being a buried pipe, running generally north & south.

